

NOTES

1. FOR EQUIPMENT N°S SEE MATERIAL HANDLING AND EQUIPMENT INSTALLATION SPEC A11-4000-51

EQUIPMENT LIST


ITEM N°	DESCRIPTION
4406A	MUD MODULE
4406A	pedestal Crane No. 1
4901	MUD GUTTER
5407A	Crane pedestal No. 1

FRACTURING MODULES

ITEM N°	DESCRIPTION


REFERENCE DRAWINGS

Drilling Module & Substructure General Layout EL+32132	2100-01
Drilling Module & Substructure General Layout EL+36592	2100-02
Drilling Modules & Substructure General Layout EL+41842	2100-03
Drilling Modules & Substructure General Layout EL+48412	2100-04

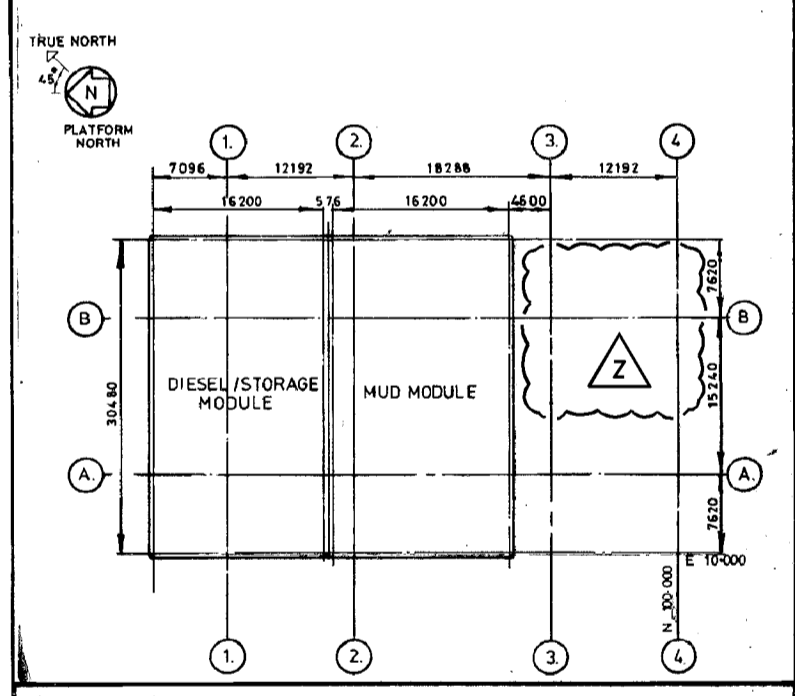

APPROVED FOR ISSUE

REV. 02 AMENDMENT 02 CONSTRUCTION
 SIGNED: Frank Wood DATE: 27/11/20
 R.D.S. AMOCO NORWAY

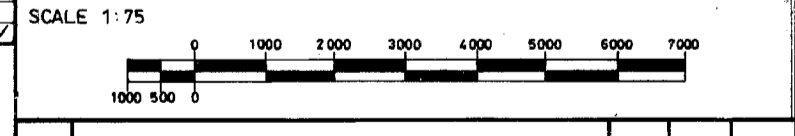

REV.	DESCRIPTION	DATE
Z	AS BUILT AFA V3826	06/10/20
C3	Mod. 2582	20/04/20
C2	UPDATED & REISSUED FOR CONSTRUCTION	07/11/20
C1	UPDATED & RE-ISSUED FOR CONSTRUCTION	09/02/20
B3	REISSUED FOR APPROVAL	04/11/19
B2	REDRAWN REISSUED FOR APPROVAL	04/11/19

RIG DESIGN SERVICES LTD
 CONSULTING ENGINEERS
 4 GREAT PORTLAND STREET, LONDON W1N 5AA, ENGLAND
 TELEPHONE 01-477 7000 TELEFAX 01-477 7000

CLIENT: AMOCO
 PROJECT: VALHALL DEVELOPMENT
 TITLE: DRILLING MODULES & SUBSTRUCTURE WEST ELEVATIONS

DESIGNED: R.D.S. SCALE: 1:75
 DRAWN: A.M. 22 NOV 20
 CHECKED: M.M. 04/12/20

DRAWING NO. A11-2100-05
 DATE: 27/11/20