


NOZZLE	DIM.	CLASS	NO. BOLT x DIM
N1	4"	150#	8 x 3/4"x110
N2	4"	150#	8 x 3/4"x110

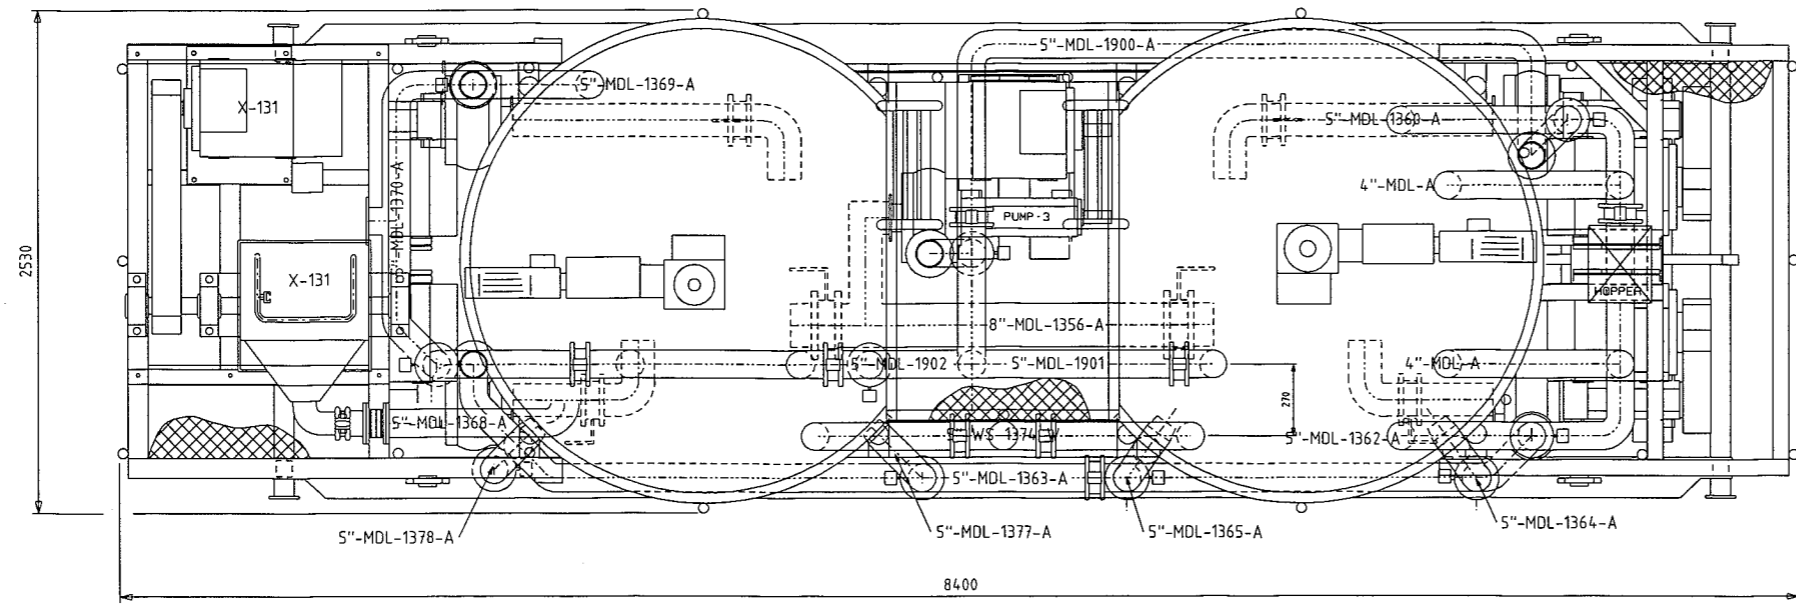

SWL LIFTING LUGS 13500 KG
SWL 18100 KG

This drawing / report / document contains proprietary information belonging to AMOCO and may not be wholly or partially reproduced nor disclosed without prior written permission of Amoco Norway Oil Company.

	IKM Laboratorium AS	Dwg. No. 4499- E.01 - 001
	Title GENERAL ARRANGEMENT PROCESS UNIT	
AS BUILT	22 nov. 99	RU NK
01 ISSUED FOR CONSTRUCTION	20 Sep 99	SAK NK
00 ISSUED FOR APPROVAL	16 Aug 99	SAK NK
Rev.	Description	Date
A302		



Amoco Norway Oil Company

AS BUILT	22 nov. 99	RU NK	Drawn by	Checked	Approved	2	3
01 ISSUED FOR CONSTRUCTION	20 Sep 99	SAK NK	Date	Date	Date	Date	Date
00 ISSUED FOR APPROVAL	16 Aug 99	SAK NK	Sign.	Sign.	Sign.	Sign.	Sign.

Drawing No.:	07-61-00-ME-001-02	Rev.	Z	Sheet	2 of 2
--------------	--------------------	------	---	-------	--------