



PLATFORM  
NORTH

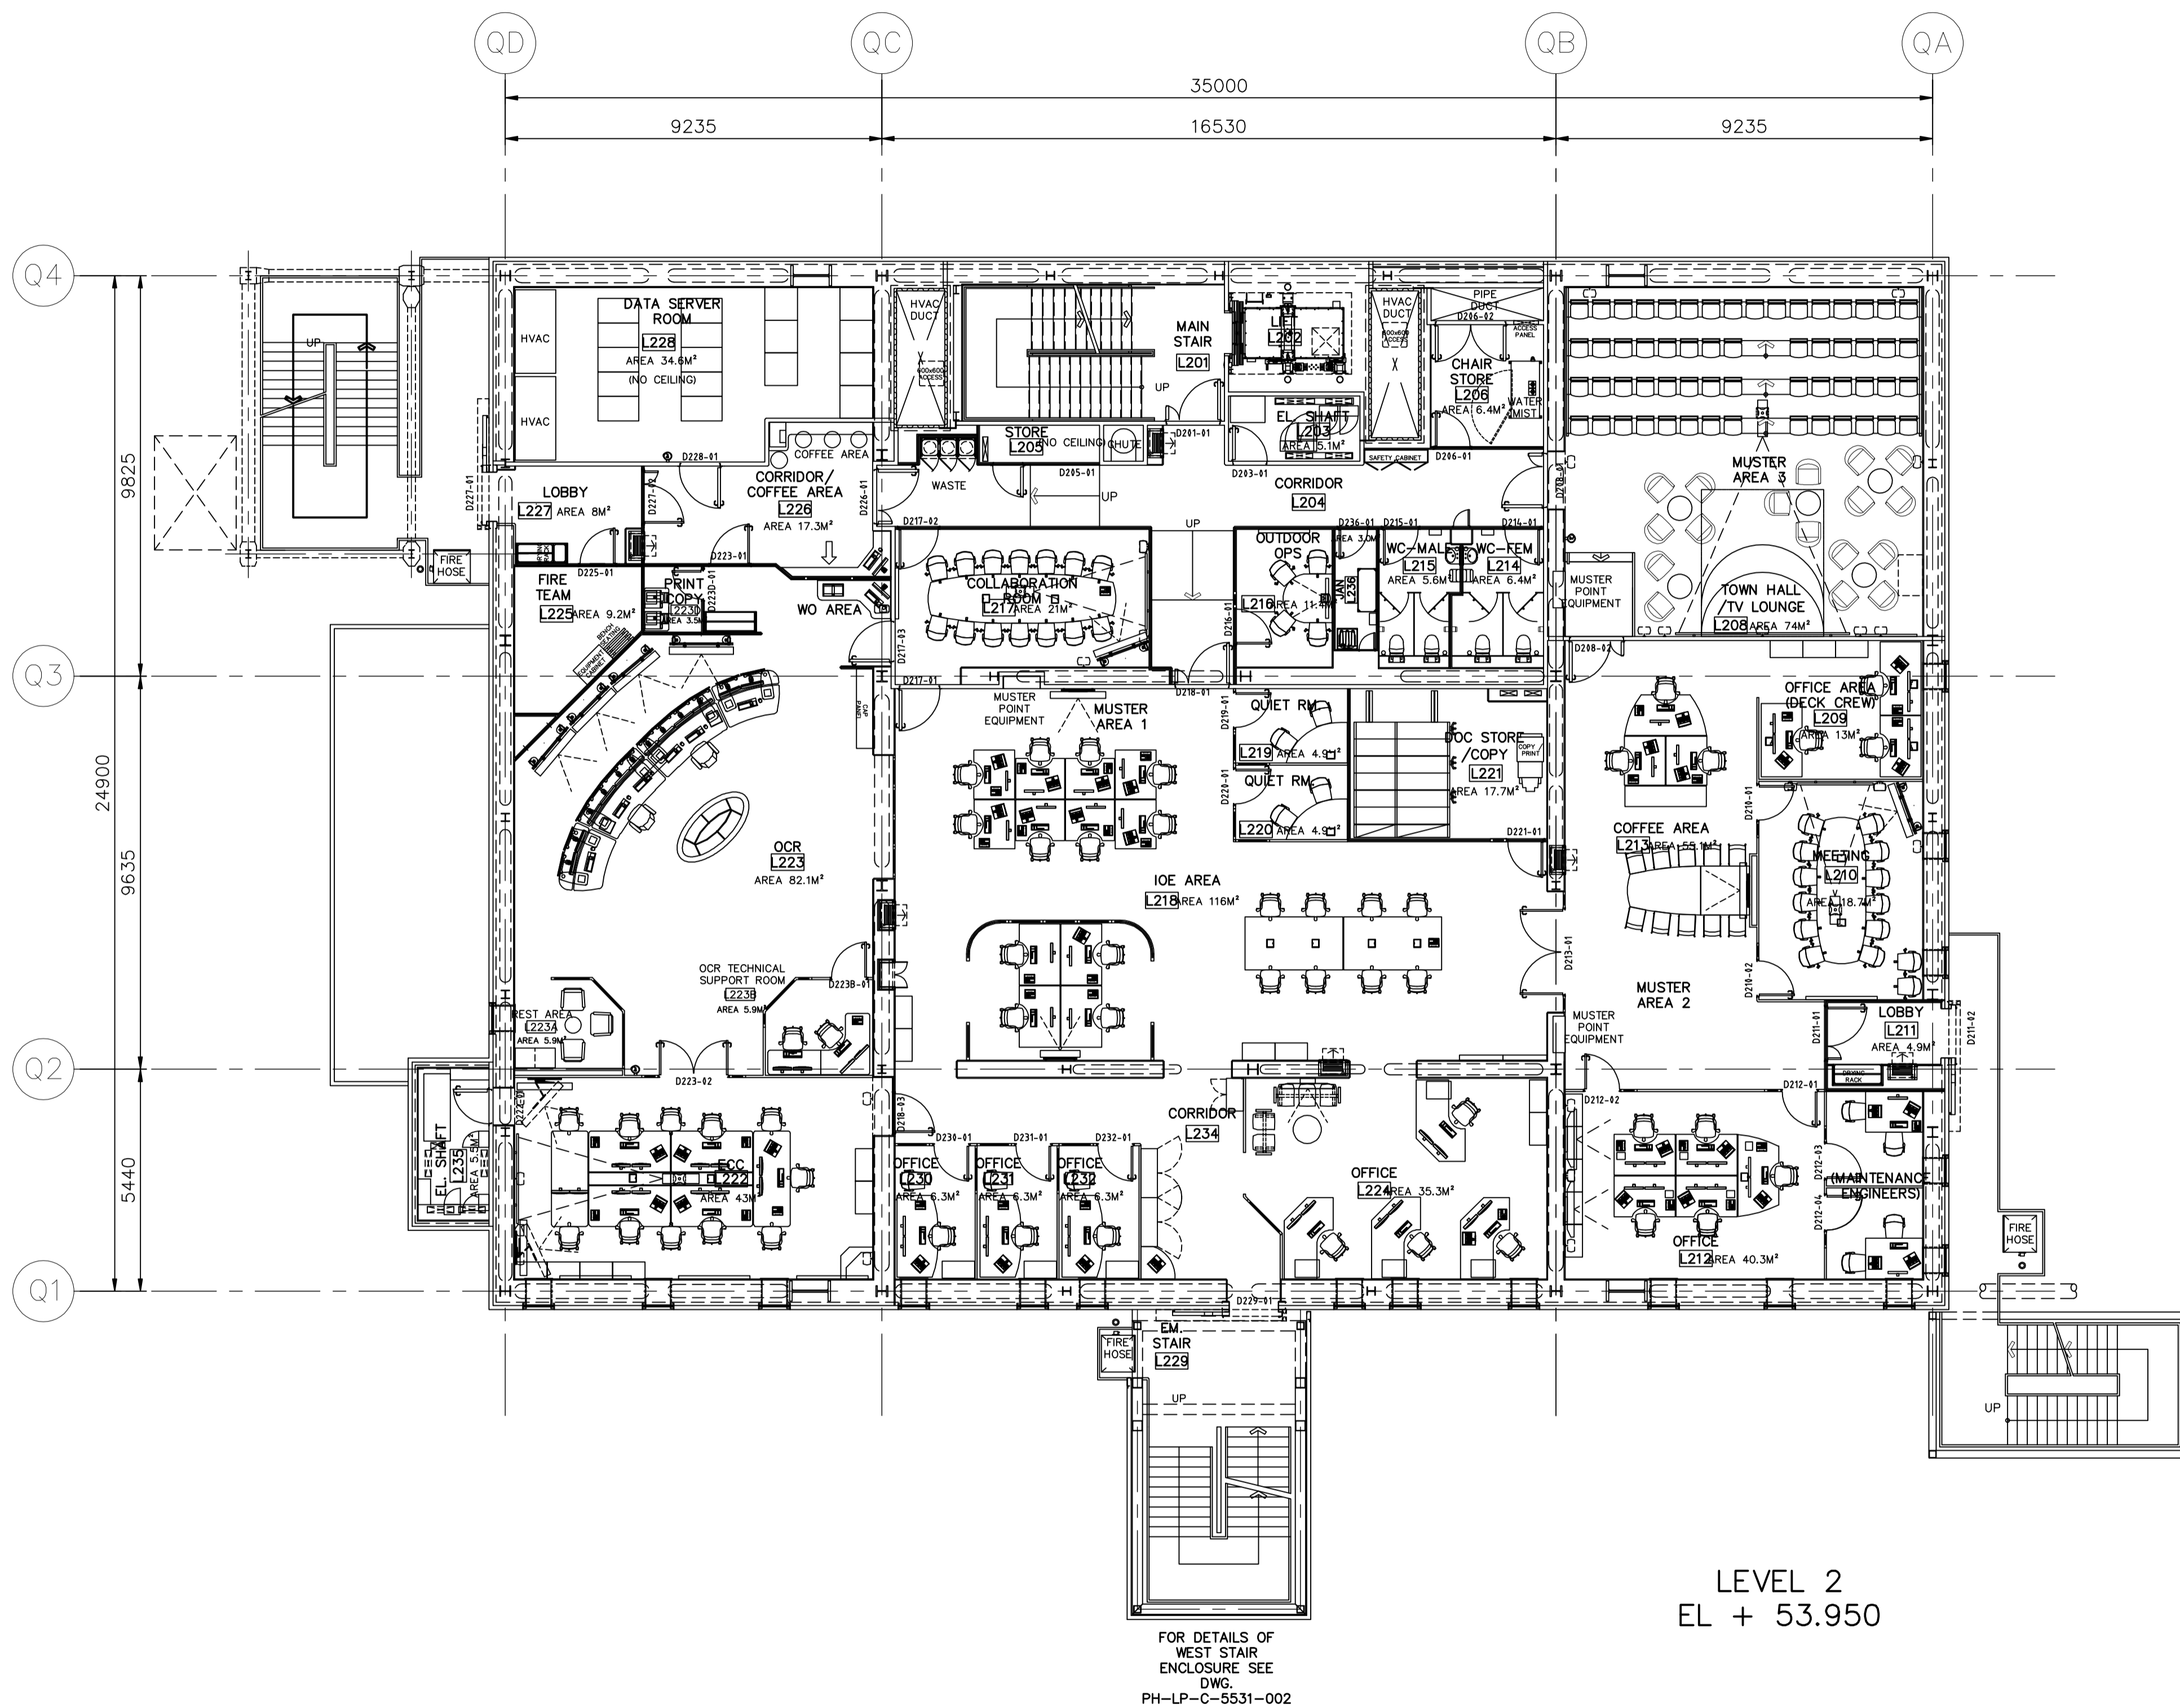

LEVEL 2  
EL + 53.950

**NOTES**

1. NORTH EAST, WEST AND SOUTH WEST EXTERNAL STAIR TOWERS BY BAYARDS a.s. SEE DRAWINGS -  
 PH-LP-N-3002-001 - PLAN VIEWS NORTH EAST TOWER  
 PH-LP-N-2002-001 - PLAN VIEWS SOUTH WEST TOWER  
 PH-LP-N-1002-001 - PLAN VIEWS WEST TOWER
2. WEST STAIR TOWER TO BE ENCLOSED FROM LEVEL 2 AND BELOW
3. FOR DETAILED SETTING OUT OF PARTITIONS SEE DRAWINGS -  
 PH-LP-0720-5322-001 LQ PARTITION LAYOUT LEVEL 2  
 PH-LP-0720-5322-002 LQ PARTITION DETAILS LEVEL 2
4. THIS DRAWING TO BE READ IN CONJUNCTION WITH DETAILED ROOM LAYOUTS -  
 PH-LP-C-5542-001 LQ Room Layout L2 206 Store  
 PH-LP-C-5553-001 LQ Room Layout L2 225 Fire Team  
 PH-LP-C-5554-001 LQ Room Layout L2 217 Collaboration  
 PH-LP-C-5557-001 LQ Room Layout L2 223 OCR  
 PH-LP-C-5558-001 LQ Room Layout L2 222 ECC  
 PH-LP-C-5559-001 LQ Room Layout L2 218 IOE Area  
 PH-LP-C-5561-001 LQ Room Layout L2 219 Quiet Room  
 PH-LP-C-5562-001 LQ Room Layout L2 220 Quiet Room  
 PH-LP-C-5563-001 LQ Room Layout L2 215 Female Toilet  
 PH-LP-C-5564-001 LQ Room Layout L2 208 Town Hall  
 PH-LP-C-5590-001 LQ Room Layout L2 228 Data Server Room  
 PH-LP-C-5607-001 LQ Room Layout L2 236 Janitor  
 PH-LP-C-5632-001 LQ Room Layout L2 204 Corridor  
 PH-LP-C-5633-001 LQ Room Layout L2 209 Office Area  
 PH-LP-C-5634-001 LQ Room Layout L2 210 Meeting Room  
 PH-LP-C-5635-001 LQ Room Layout L2 211 Lobby  
 PH-LP-C-5636-001 LQ Room Layout L2 212 Office  
 PH-LP-C-5637-001 LQ Room Layout L2 213 Coffee Area  
 PH-LP-C-5638-001 LQ Room Layout L2 216 Outdoor Ops  
 PH-LP-C-5639-001 LQ Room Layout L2 221 Doc. Store/Copy  
 PH-LP-C-5640-001 LQ Room Layout L2 224 Office  
 PH-LP-C-5641-001 LQ Room Layout L2 226 Corridor/Coffee  
 PH-LP-C-5642-001 LQ Room Layout L2 227 Lobby  
 PH-LP-C-5643-001 LQ Room Layout L2 230 Office  
 PH-LP-C-5644-001 LQ Room Layout L2 231 Office  
 PH-LP-C-5645-001 LQ Room Layout L2 232 Office  
 PH-LP-C-5647-001 LQ Room Layout L2 234 Corridor  
 PH-LP-C-5674-001 LQ Room Layout L2 220 Quiet Room  
 PH-LP-C-5681-001 LQ Room Layout L2 235 EL. Shaft

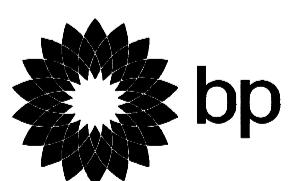REV. No.	DESCRIPTION OF REVISION	ISSUE DATE	MADE BY	CHK'D BY	DISC. BY	PROJ. NO.	CLIENT REV. No.	DESCRIPTION OF REVISION	ISSUE DATE	MADE BY	CHK'D BY	DISC. BY	PROJ. NO.	CLIENT REV. No.	REFERENCE DRAWINGS:	DRAWING TITLE:		LIVING QUARTERS GA LAYOUT LEVEL 2				SCALE <b>1:100</b> REV. <b>Z1</b>		
																REGISTRATION CODES		DRAWING NO.						
															PH-LP-E-5441-003	TYPICAL TERMINATION DIAGRAM	AREA	SYSTEM	TYPE	FACILITY CODE	ORIG.	DISP.	SEQ. No.	SHEET
															PH-LP-E-5433	LQ - LIGHTING & SP LAYOUT - LEVEL 4	L2	00	XD	PH	LP	C	5302	001
Z1	AS BUILT	07.01.11	DA	SW	DH	AMA									PH-LP-E-0305-001	TYPICAL TERMINATION DIAGRAM								
Z	AS BUILT	02.09.10	DA	SW	DH	AMA									PH-LP-E-0302-001/002	LIGHTING & SP STANDARD NOTES AND SYMBOLS								

**WALHALL RE-DEVELOPMENT**  
PROJECT No. C06106

**SLP**  
SLP ENGINEERING LTD  
HAMILTON ROAD  
LOWESTOFT  
SUFFOLK, NR32 1XF