


PLATFORM NORTH

WASTE/STORAGE SCHEDULE

1. COMPACTOR - RESIDUAL WASTE FOR ENERGY/FOOD
2. CONTAINER - REFRIGERATED GROCERY CONTAINER
3. CONTAINER - REFRIGERATED GROCERY CONTAINER
4. REFRIGERATED GROCERY CONTAINER
5. REFRIGERATED GROCERY CONTAINER
6. PLASTIC/STEEL DRUM - GLASS AND METAL

NOTES



1. NORTH EAST, WEST AND SOUTH WEST EXTERNAL STAIR TOWERS BY BAYARDS O.A. SEE DRAWINGS - PH-LP-N-1002-001 - PLAN VIEWS NORTH EAST TOWER PH-LP-N-2002-001 - PLAN VIEWS SOUTH WEST TOWER PH-LP-N-1002-001 - PLAN VIEWS WEST TOWER
2. FOR DETAILED SETTING OUT OF PARTITIONS SEE DRAWINGS - PH-LP-0720-5323-001 LO PARTITION LAYOUT LEVEL 3 PH-LP-0720-5323-002 LO PARTITION DETAILS LEVEL 3
3. THIS DRAWING TO BE READ IN CONJUNCTION WITH DETAILED ROOM LAYOUTS - PH-LP-C-5313-001 LO Room Layout Level 3 1,328 Lobby PH-LP-C-5341-001 LO Room Layout Level 3 1,340 Change PH-LP-C-5342-001 LO Room Layout Level 3 1,338 WC PH-LP-C-5345-001 LO Room Layout Level 3 1,338 WC and Elect. Dist. Room PH-LP-C-5348-001 LO Room Layout Level 3 1,319 Janitor and Store PH-LP-C-5354-001 LO Room Layout Level 3 1,316 Lobby PH-LP-C-5355-001 LO Room Layout Level 3 1,356A Sauna PH-LP-C-5373-001 LO Room Layout Level 3 1,320 Cold Room PH-LP-C-5374-001 LO Room Layout Level 3 1,321 Gallery Corridor PH-LP-C-5375-001 LO Room Layout Level 3 1,325 Cold Room PH-LP-C-5376-001 LO Room Layout Level 3 1,326 Cold Room PH-LP-C-5377-001 LO Room Layout Level 3 1,327 Freezer Room PH-LP-C-5378-001 LO Room Layout Level 3 1,330 Freezer Room PH-LP-C-5392-001 LO Room Layout Level 3 1,338B Changing Room PH-LP-C-5396-001 LO Room Layout Level 3 1,322 Lobby PH-LP-C-5397-001 LO Room Layout Level 3 1,323 Meet. and Fish Prep PH-LP-C-5408-001 LO Room Layout Level 3 1,339 Lobby PH-LP-C-5533-001 LO Room Layout Level 3 1,341 Sauna PH-LP-C-5555-001 LO Room Layout Level 3 1,333 Corridor PH-LP-C-5566-001 LO Room Layout Level 3 1,332 Activity / TV Room PH-LP-C-5567-001 LO Room Layout Level 3 1,334 Music Room PH-LP-C-5568-001 LO Room Layout Level 3 1,335 Exercise Room PH-LP-C-5570-001 LO Room Layout Level 3 Balcony PH-LP-C-5572-001 LO Room Layout Level 3 1,342 Relaxation Lounge PH-LP-C-5574-001 LO Room Layout Level 3 Levels 3 to 7 Atrium Area PH-LP-C-5574-002 LO Room Layout Level 3 Levels 3 to 7 Atrium Area PH-LP-C-5574-003 LO Room Layout Level 3 Levels 3 to 7 Atrium Area PH-LP-C-5574-004 LO Room Layout Level 3 Levels 3 to 7 Atrium Area PH-LP-C-5574-005 LO Room Layout Level 3 Levels 3 to 7 Atrium Area PH-LP-C-5574-006 LO Room Layout Level 3 Levels 3 to 7 Atrium Area PH-LP-C-5575-001 LO Room Layout Level 3 1,321 Gallery PH-LP-C-5578-001 LO Room Layout Level 3 1,329 Dry Stores PH-LP-C-5579-001 LO Room Layout Level 3 1,317 Delivery / Scullery PH-LP-C-5580-001 LO Room Layout Level 3 1,314 Catering Staff Rest Rooms PH-LP-C-5581-001 LO Room Layout Level 3 1,305 Janitor PH-LP-C-5605-001 LO Room Layout Level 3 1,315 Smoking Room PH-LP-C-5608-001 LO Room Layout Level 3 1,324 Pkg. Wash PH-LP-C-5681-001 LO Room Layout Level 3 1,306 Deliv. PH-LP-C-5692-001 LO Room Layout Level 3 1,311 WC PH-LP-C-5695-001 LO Room Layout Level 3 1,317 Lobby PH-LP-C-5696-001 LO Room Layout Level 3 1,347 El. Short PH-LP-C-5697-001 LO Room Layout Level 3 1,307 and 1,308 WC

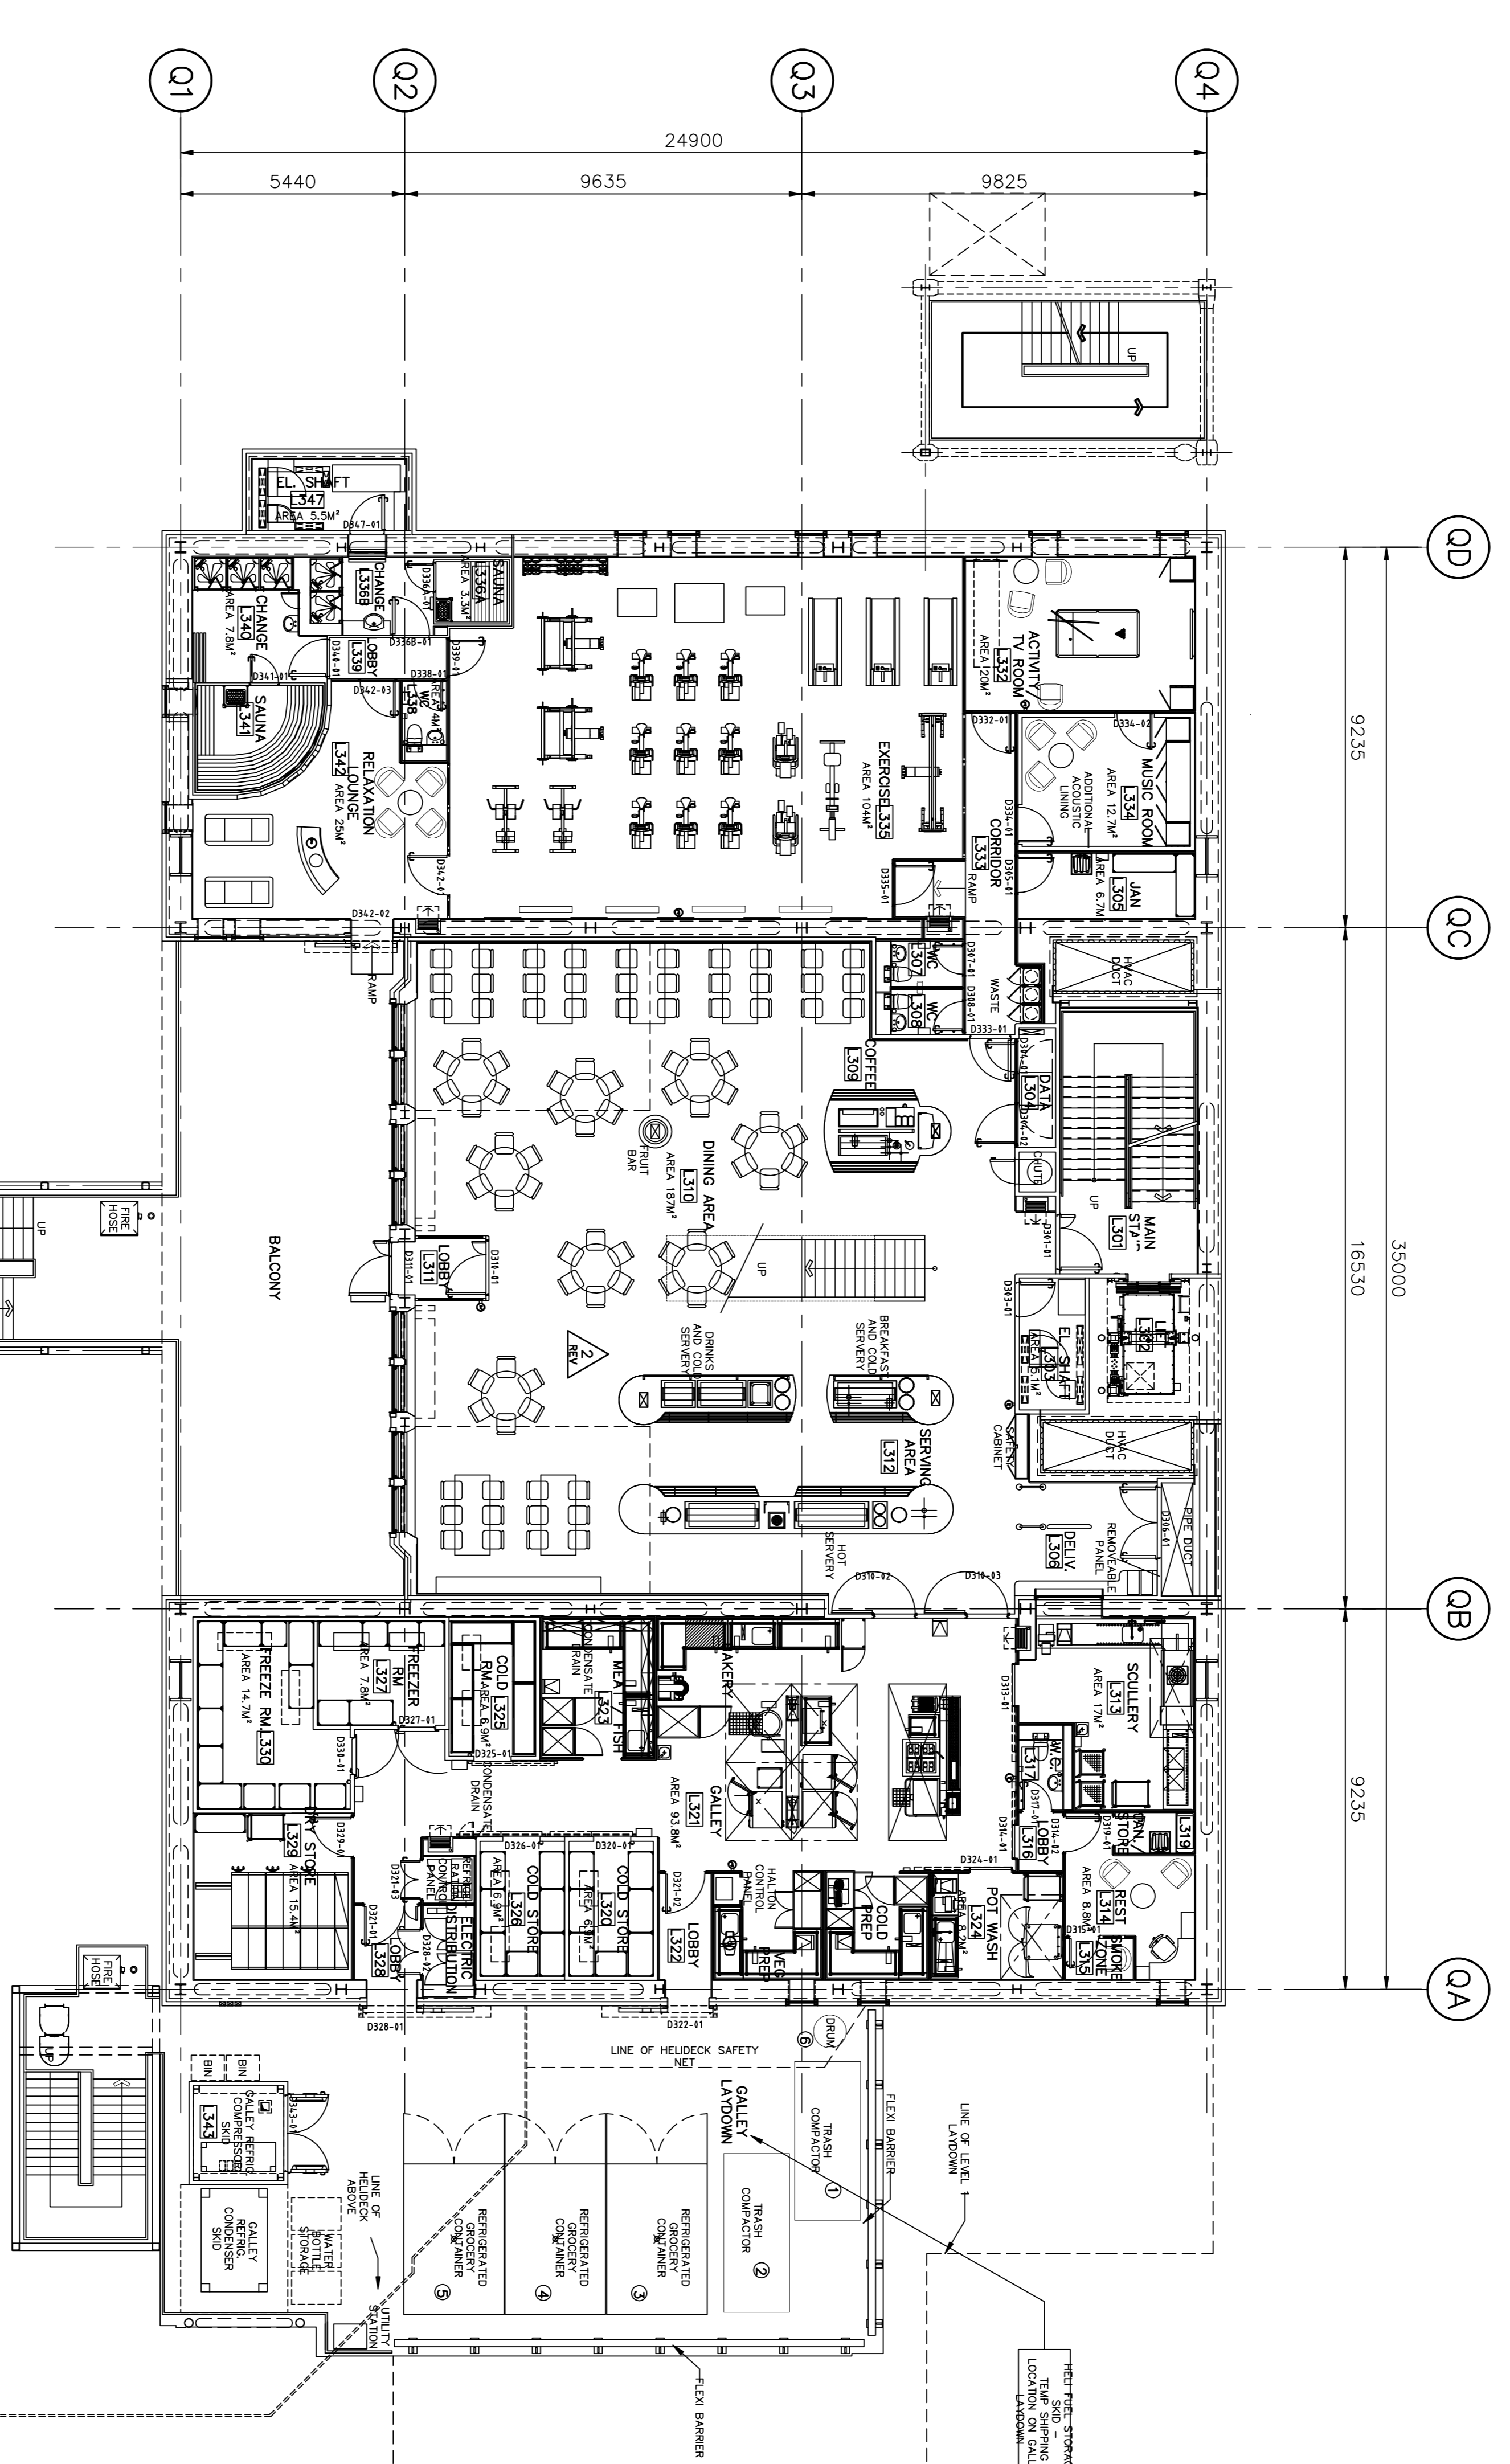

LEVEL 3
EL + 58.450

REV. No.	DESCRIPTION OF REVISION	ISSUE DATE	MADE BY	CHK'D BY	DISC. APPR. NO.	PROJ. ENGR. REV.	DESCRIPTION OF REVISION	ISSUE DATE	MADE BY	CHK'D BY	DISC. APPR. NO.
Z	AS BUILT	02.09.10	DA	SW	DH	AD					

WALTHAM RE-DEVELOPMENT
PROJECT No. C06106

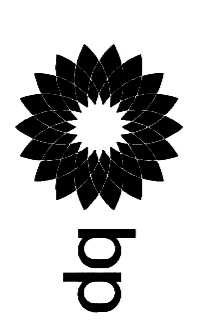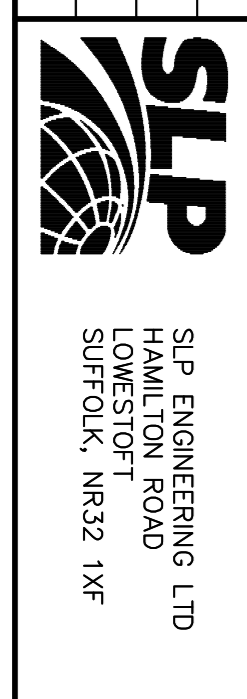

LIVING QUARTERS
GA LAYOUT
LEVEL 3

REFERENCE DRAWINGS:	DRAWING TITLE:	REGISTRATION CODES:	DRAWING NO.:
PH-LP-E-5441-003	TYPICAL TERMINATION DIAGRAM	AREA L3	1:100
PH-LP-E-5433	LO - LIGHTING & SP LAYOUT - LEVEL 4	SYSTEM 00	
PH-LP-E-0305-001	TYPICAL TERMINATION DIAGRAM	TYPE XD	
PH-LP-E-0302-001/002	LIGHTING & SP STANDARD NOTES AND SYMBOLS	FACILITY CODE PH	
		ORIG. DISP. SEQ. NO. LP C 5303 001	
		SHEET 1	