



PLATFORM NORTH

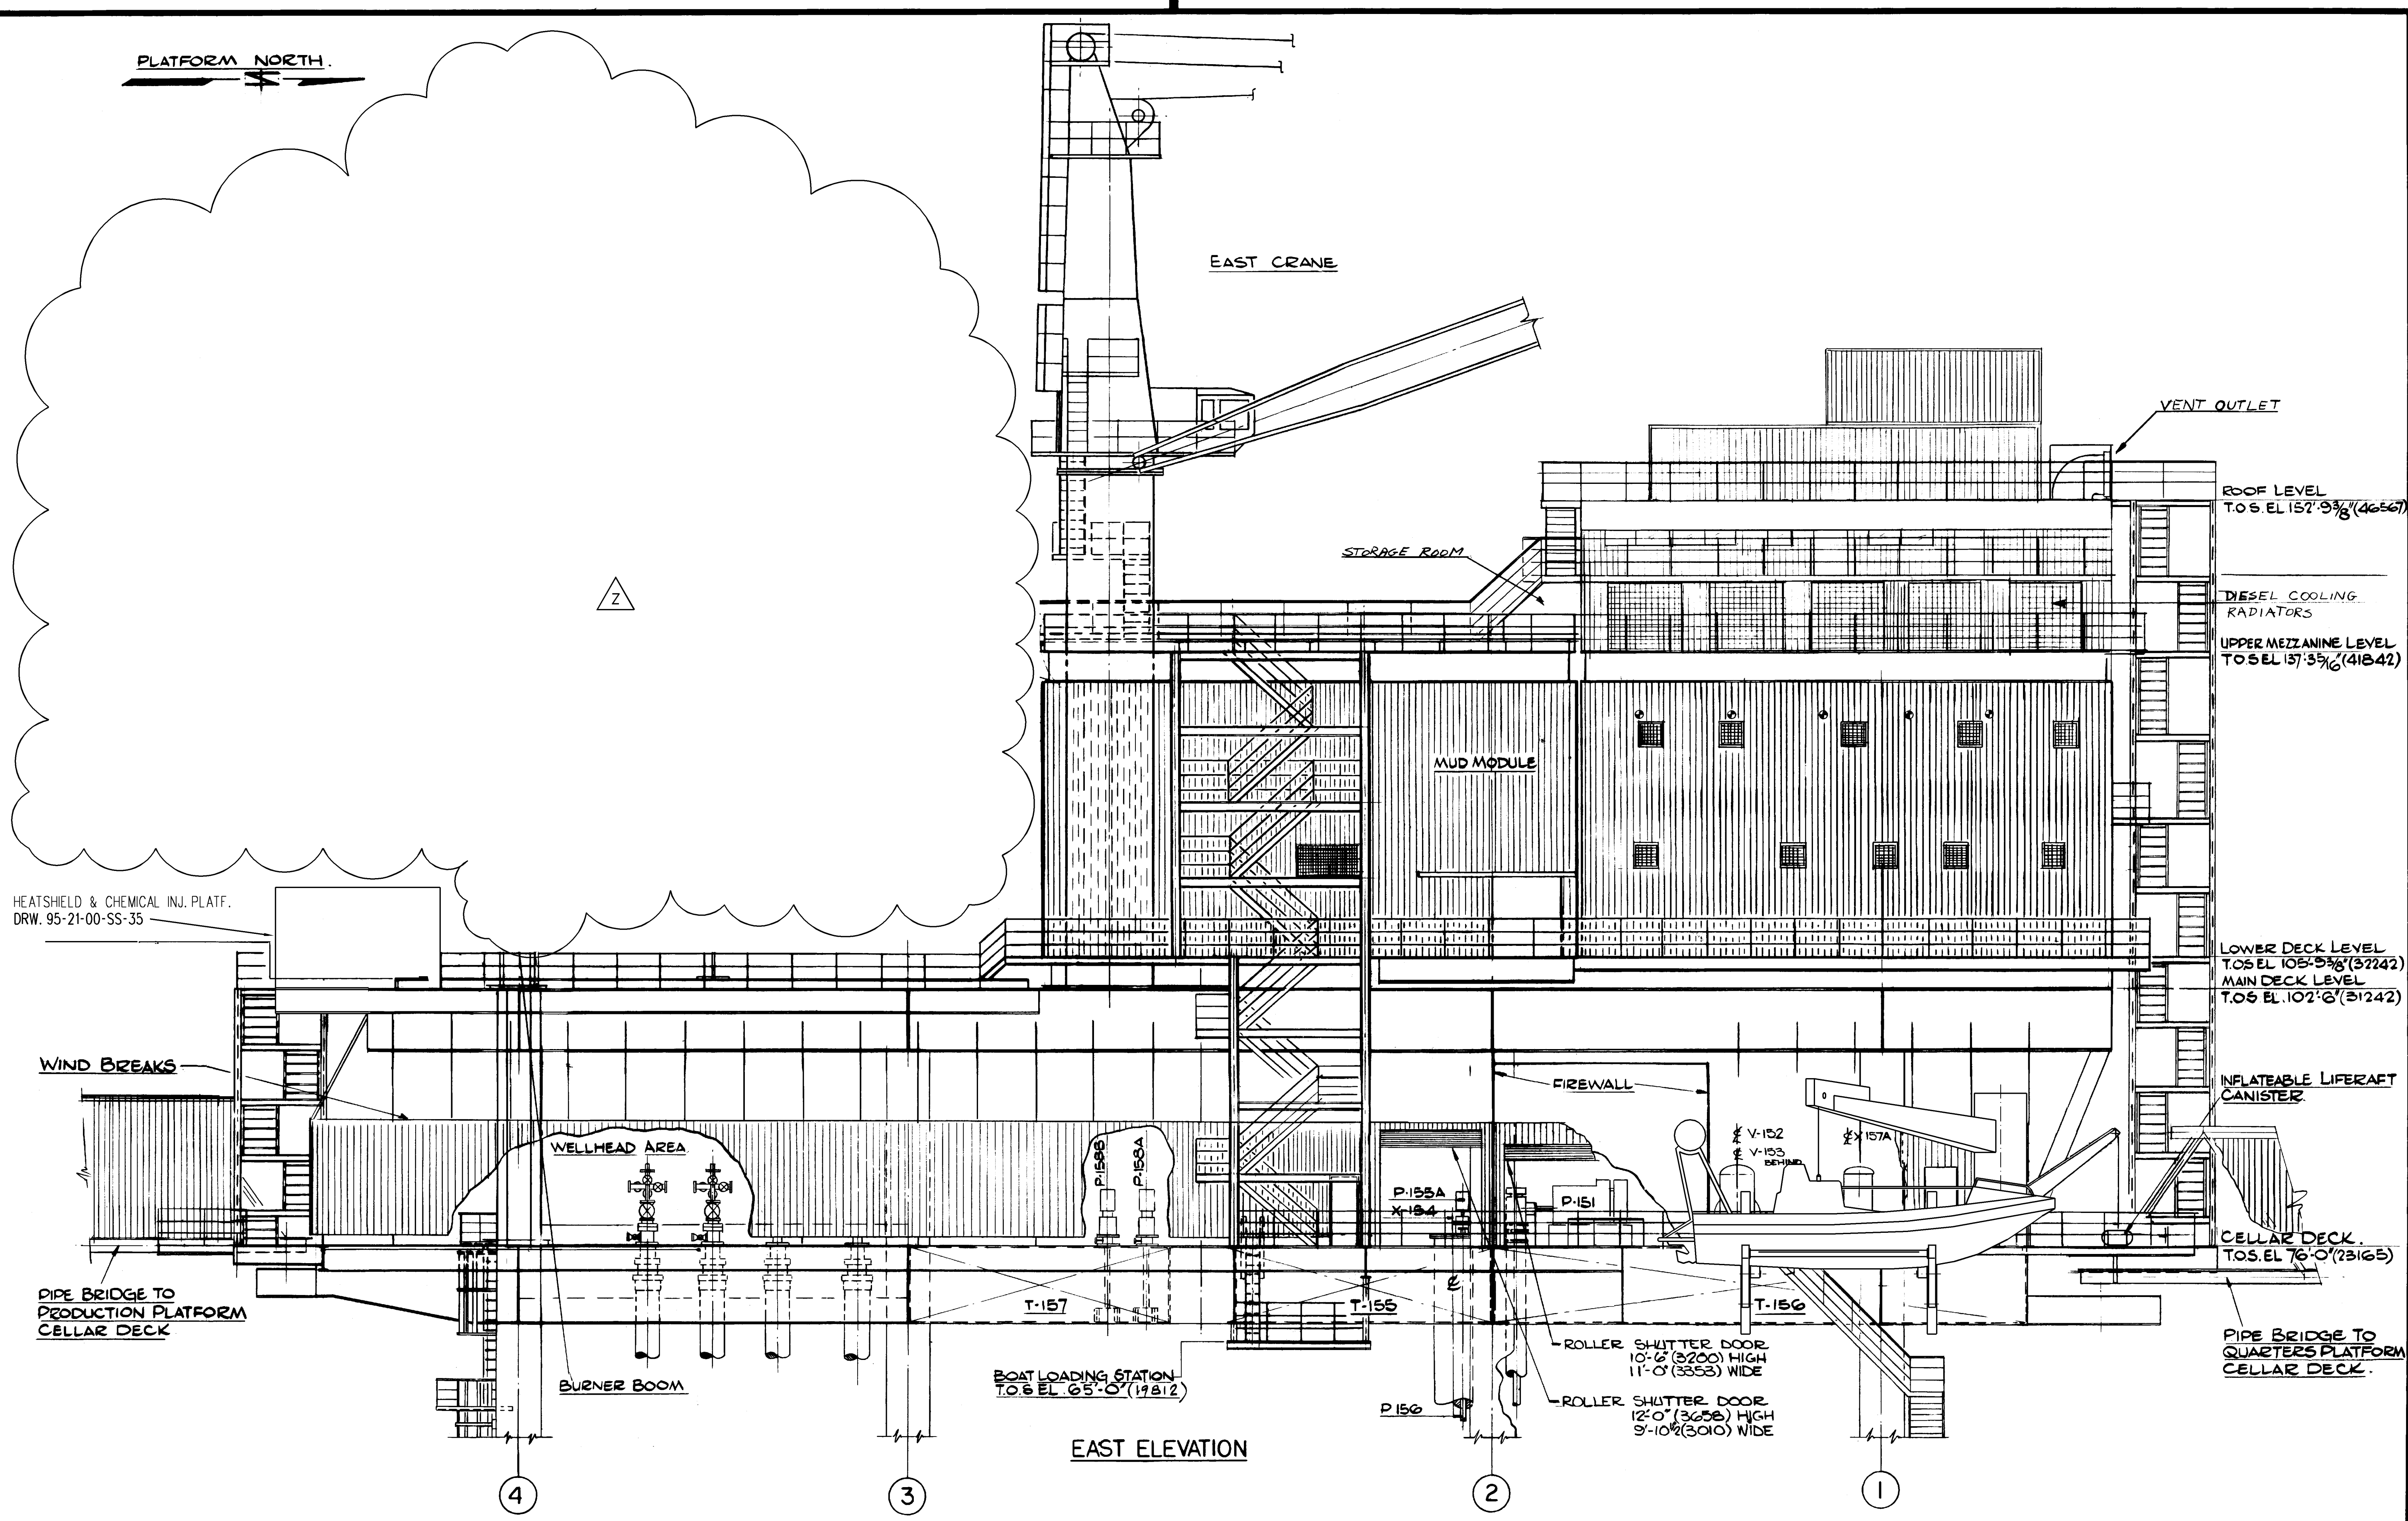

EAST ELEVATION

REV	DESCRIPTION	DATE/SIGN.	DATE/SIGN.	REV.	DESCRIPTION	DATE/SIGN.	DATE/SIGN.
Z	AS BUILT, AFA V3826			VE. J.V.	AMOCO	17.08.09	TMH/JV/MH
4	MO-92570			26.06.09	18		
3	MOD 5875			21.12.94	JHK	17.1.95	UO
2	UPDATED			24/5/98	KL		
1	ISSUED FOR CONSTRUCTION			15/6/79	DES. W.		
OA	APPROVAL FOR CONSTRUCTION			6/6/79	DES. W.		
O	ISSUED FOR BID			1/3/79	DES. W.		

**Amoco Norway Oil Company**



**VALHALL DEVELOPMENT PROJECT**  
PHASE A - PROJECT No. 554

**Valhall Engineering Joint Venture**

A/S AKERS MEK VERKSTED  
BROWNAKER OFFSHORE A/S  
KVERNER BRUG A/S

SCALE 1/8" = 1'-0"

DATE 13-1-79

DRAWN BY J. PHILLIPS

CHECKED BY D. SLANN

ENG. APPROVED 14/3/79

PRG. APPROVED

AMOCO APPROVED

TITLE: PLOT PLAN EAST ELEVATION DRILLING PLATFORM

DRAWING No. D-PP-005

REV. Z

SHEET 1 OF 1