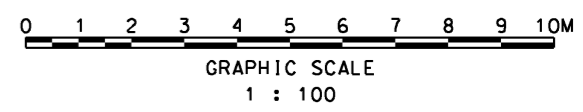
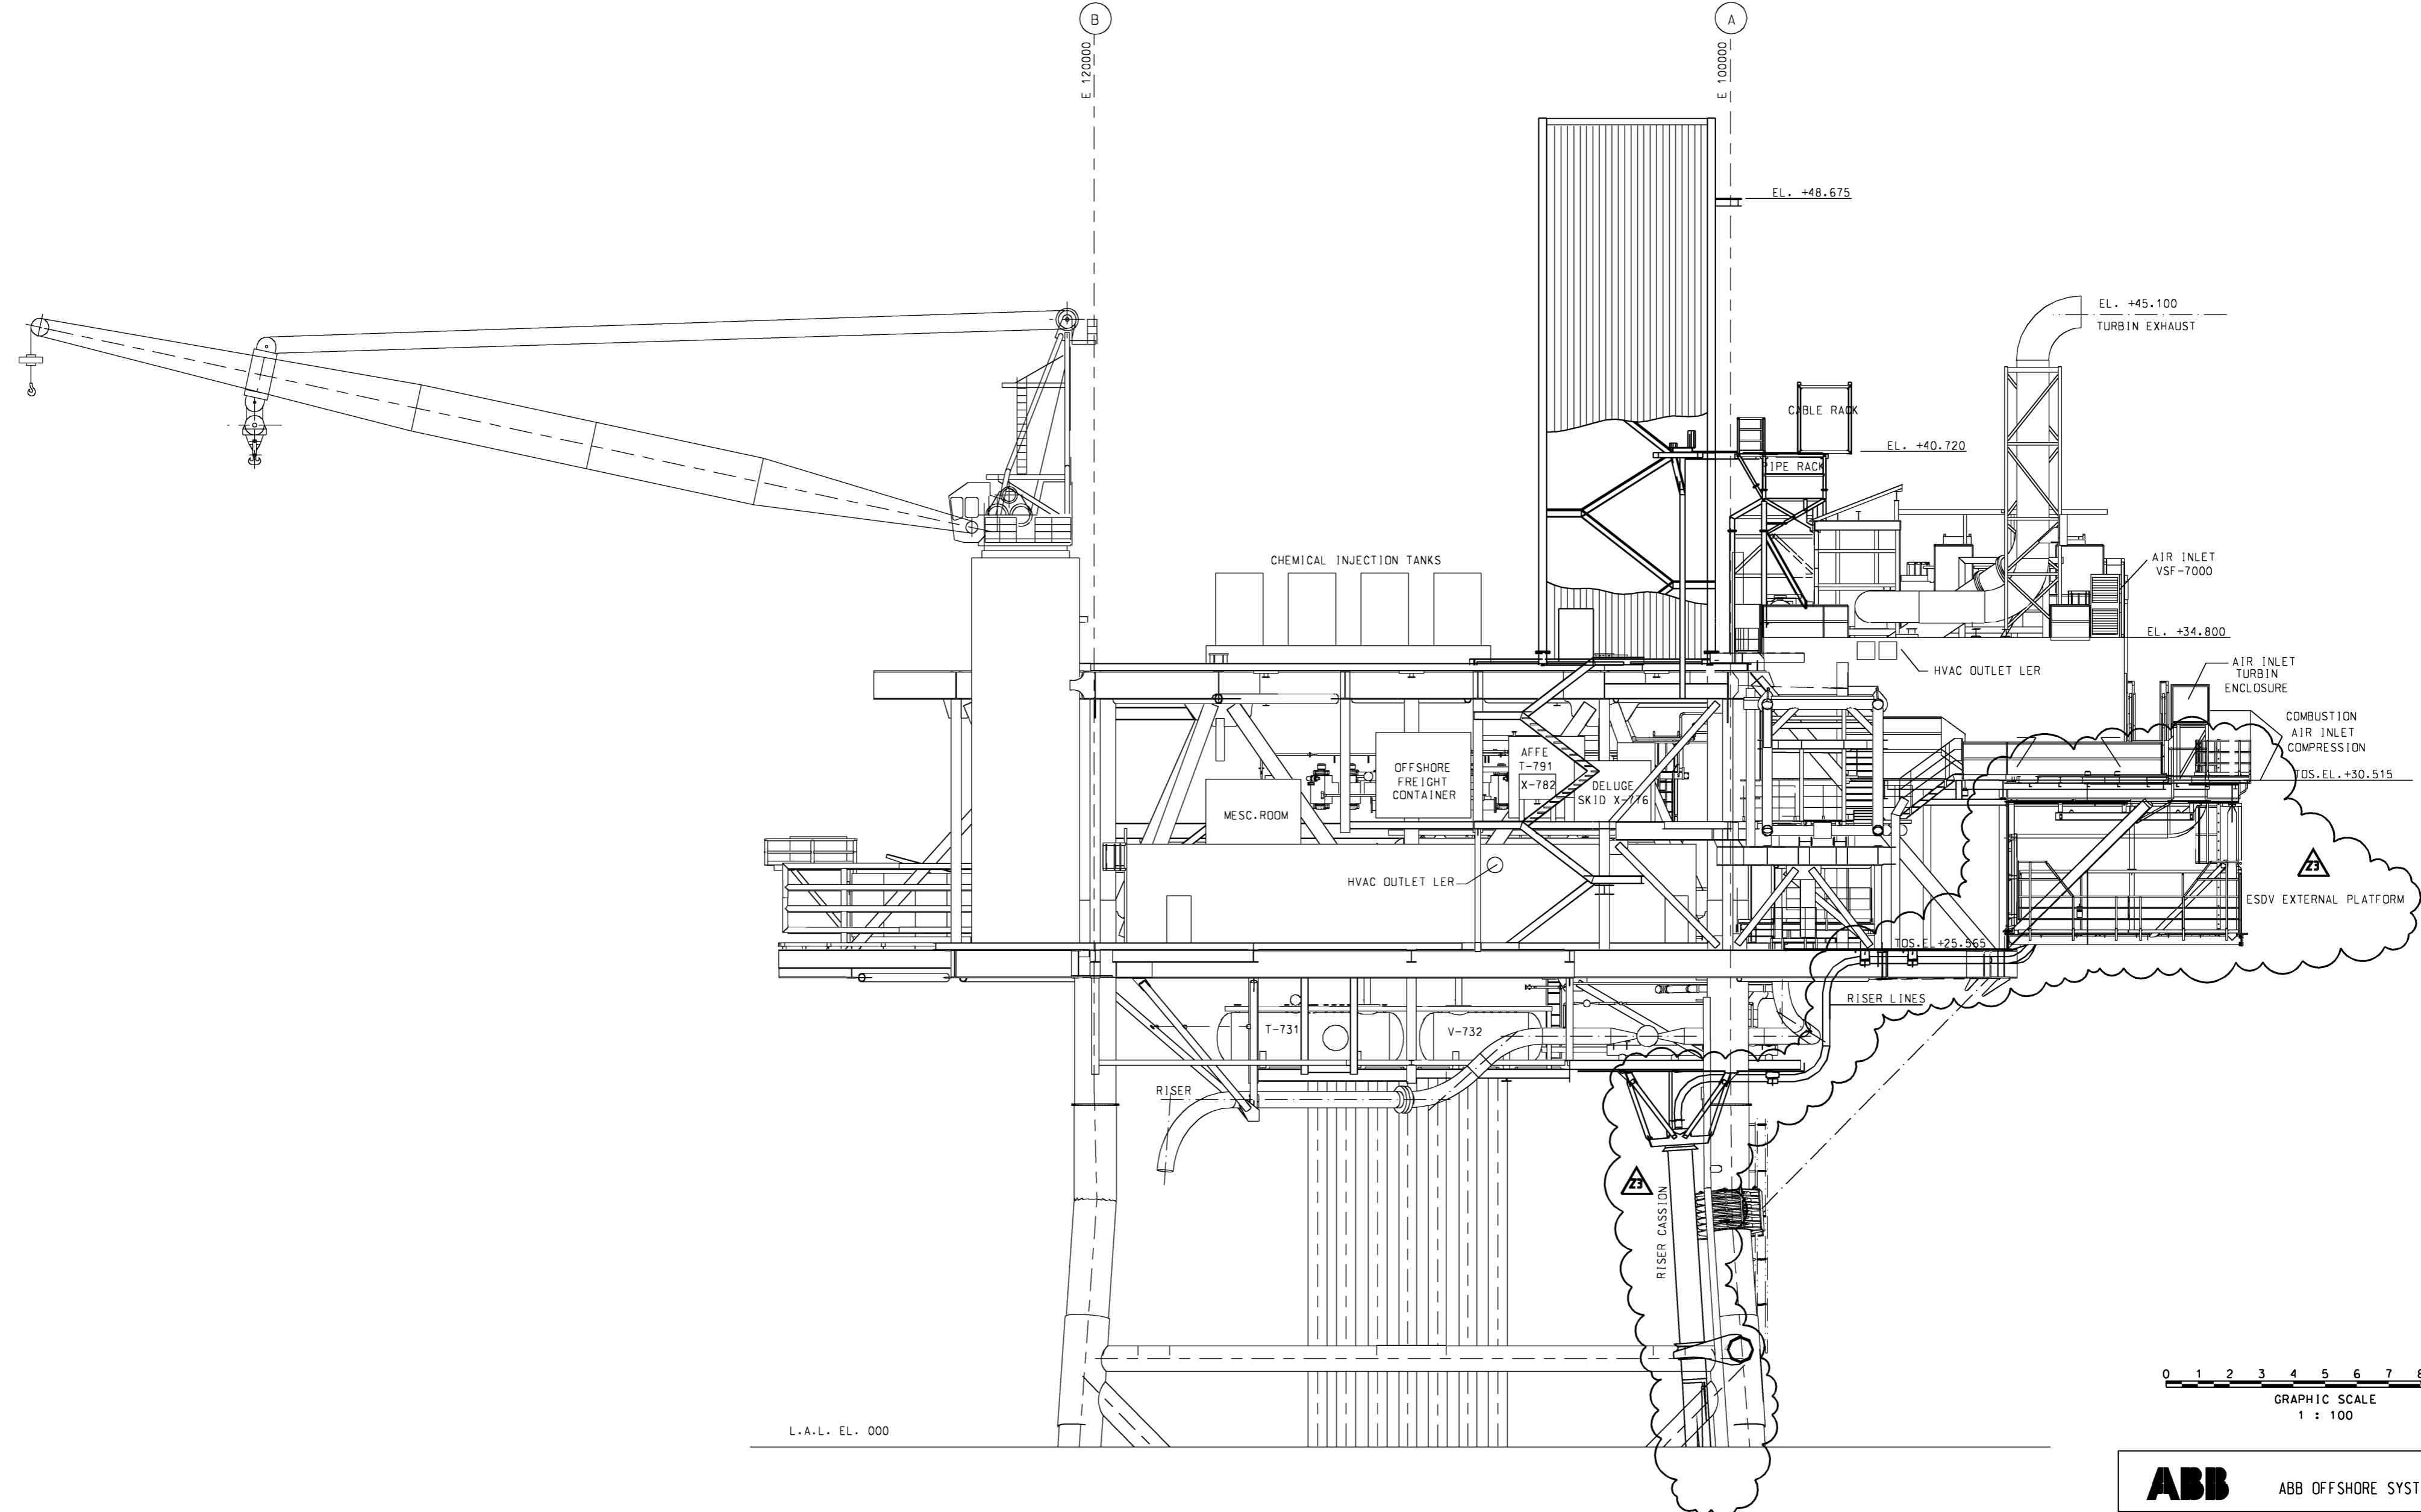


A B C D E F G H K L M N

1  
2  
3  
4  
5  
6  
7  
8



**ABB** ABB OFFSHORE SYSTEMS  
**VALHALL WP PROJECT**  
 CLIENT  
 AMOCO NORWAY OIL COMPANY

NOTES

REV	DATE	BY	DESCRIPTION	CHKD	APPD	APPD	APPROVED CLIENT	SIGNED	DATE
23	17.02.12	SS	AS BUILT VAF A-003584	JC	JC				
22	05.01.12	SS	AS BUILT VAF A-003584	JC	JC				
21	13.04.04	GB	AS BUILT C01031	PT	TH				
2	04.99	MAMY	AS BUILT- EDM MODULE INCLUDED	MAU	TA				
REFERENCE DRAWINGS									

TITLE				
PLOT PLAN				
ELEVATION LOOKING SOUTH				
SCALE	Format	DRAWING No.	SHT. No.	REV
1 : 100	A1	00-07-00-PP-012	1	Z3

1978-009