


KEY PLAN
N.T.S.

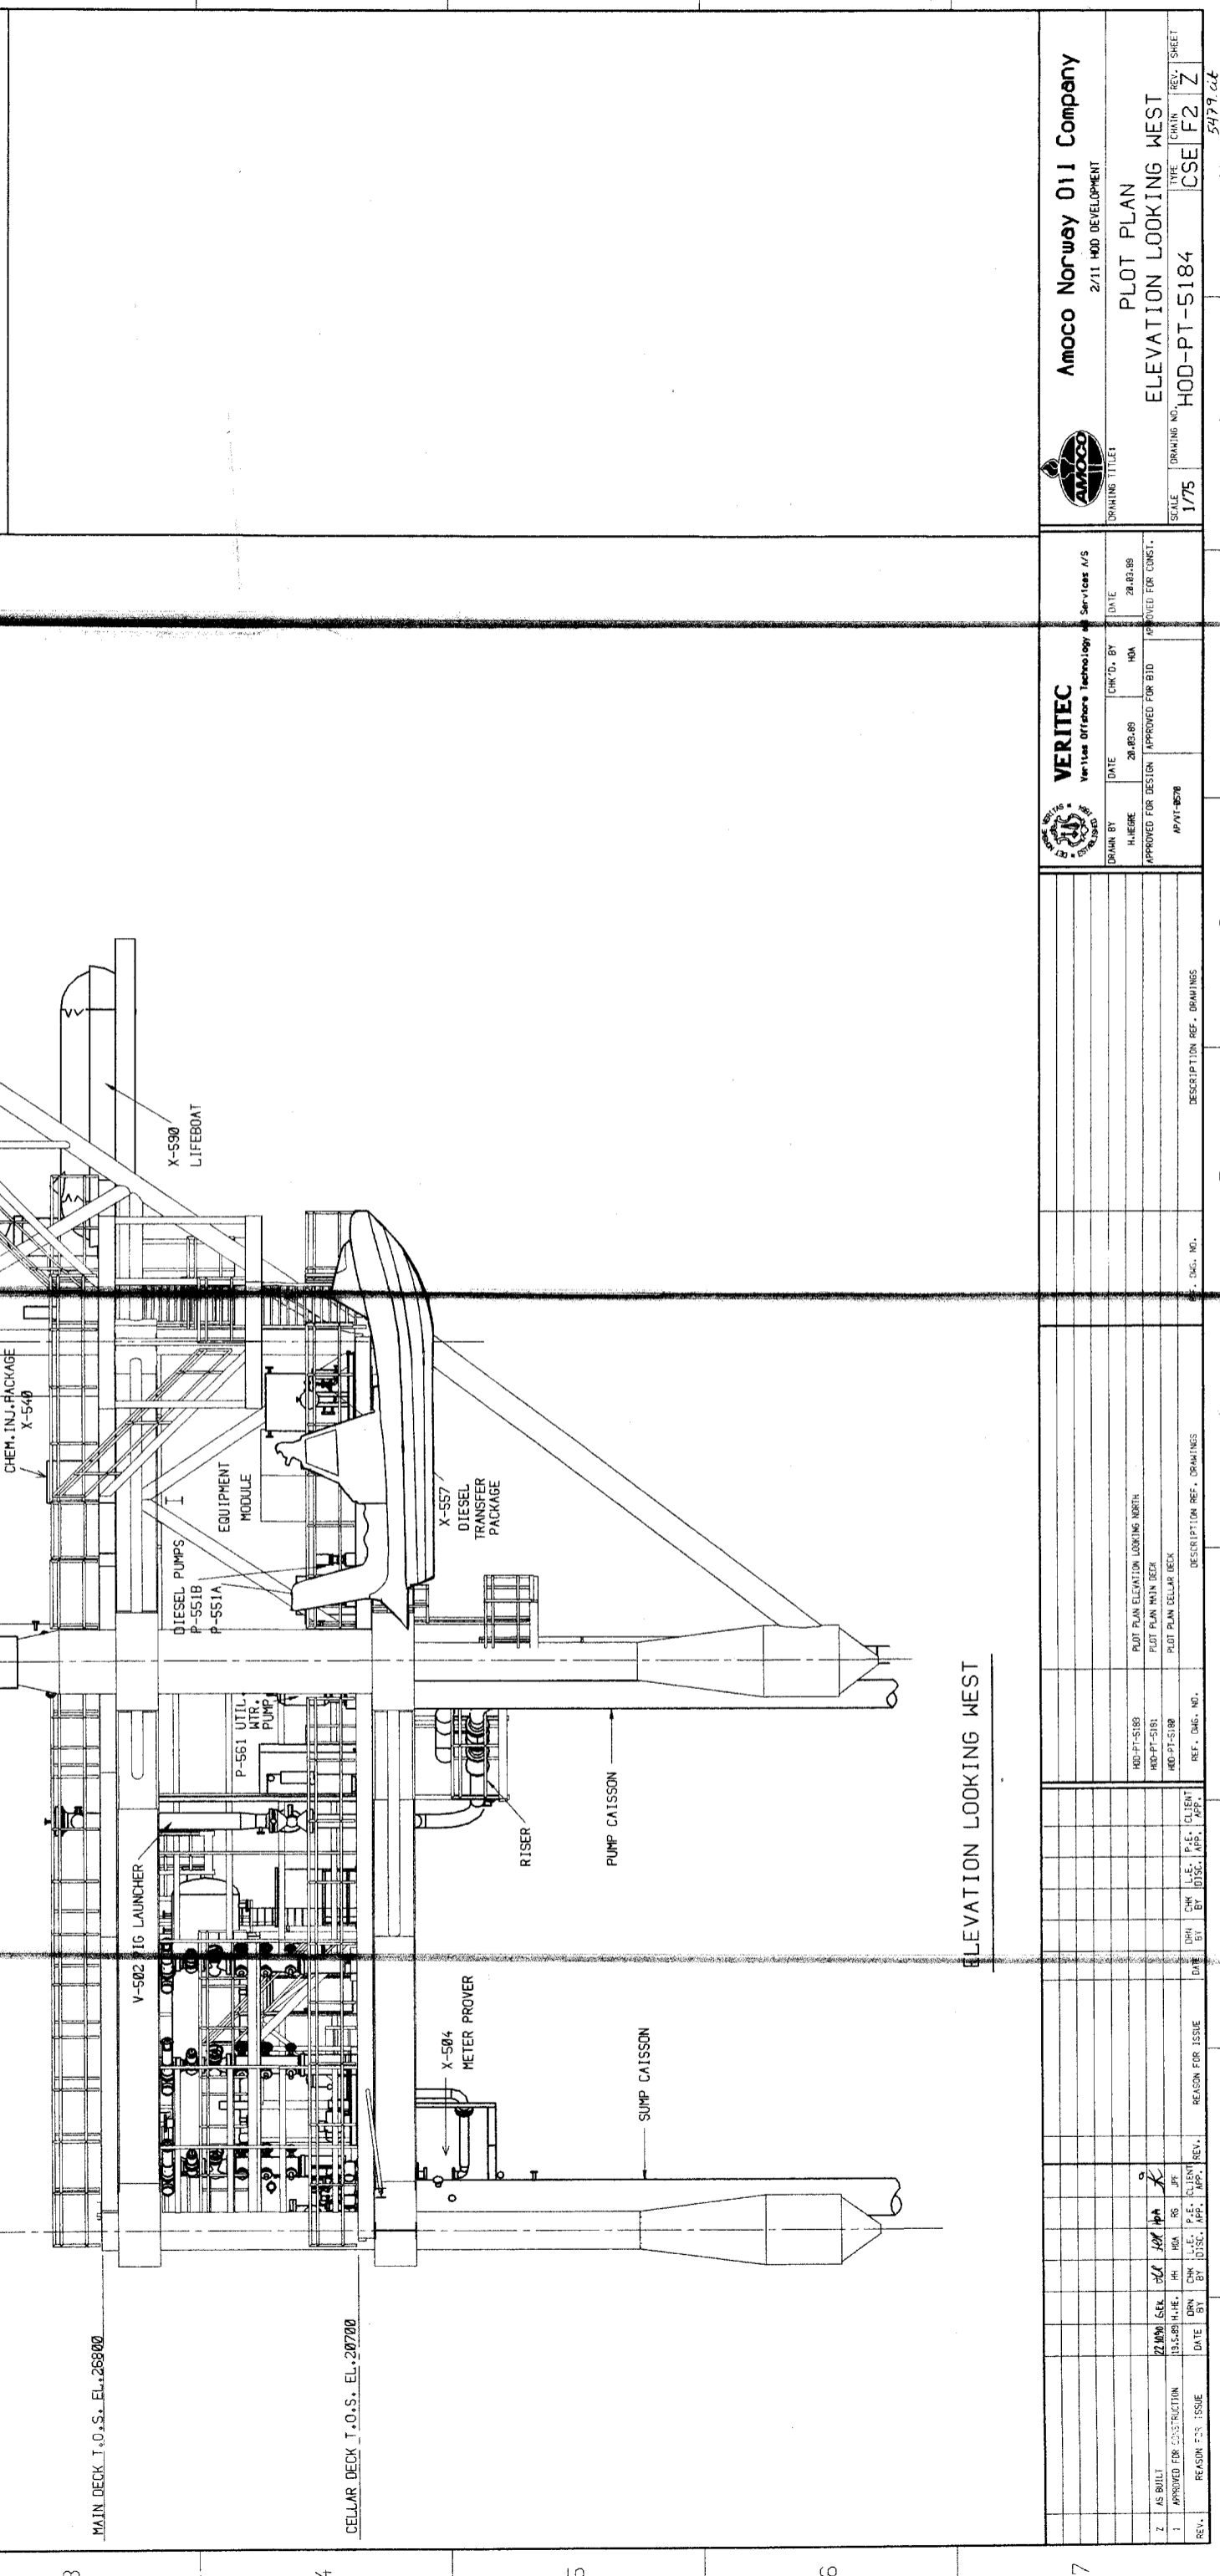

ELEVATION LOOKING WEST

		Amoco Norway Oil Company 2/11 HOD DEVELOPMENT	
DRAWING TITLE PLOT PLAN		TYPE ELEVATION LOOKING WEST	
SCALE 1/75		DRAWING NO. HOD-PT-5184	
DATE 28.08.89		CHK'D. BY HIA	
DRAWN BY H. HEIRE		DATE 28.08.89	
APPROVED FOR DESIGN AP/PT-8678		APPROVED FOR BID AP/PT-8678	
APPROVED FOR CONST. AP/PT-8678		DATE 28.08.89	
SERVICE A/S VERITEC Veritec Offshore Technology		DRAWING NO. HOD-PT-5184	
DESCRIPTION REF. - DRAWINGS		REF. CHG. NO.	
PLOT PLAN ELEVATION LOOKING NORTH		CLIENT AMOCO NORWAY OIL COMPANY	
PLOT PLAN MAIN DECK		DATE 28.08.89	
PLOT PLAN CELLAR DECK		CHK. BY HIA	
REF. CHG. NO.		REASON FOR ISSUE	
2 AS BUILT		DATE 13.09.91	
1 APPROVED FOR CONSTRUCTION		CHK. BY HIA	
REASON FOR ISSUE		DATE 28.08.89	