



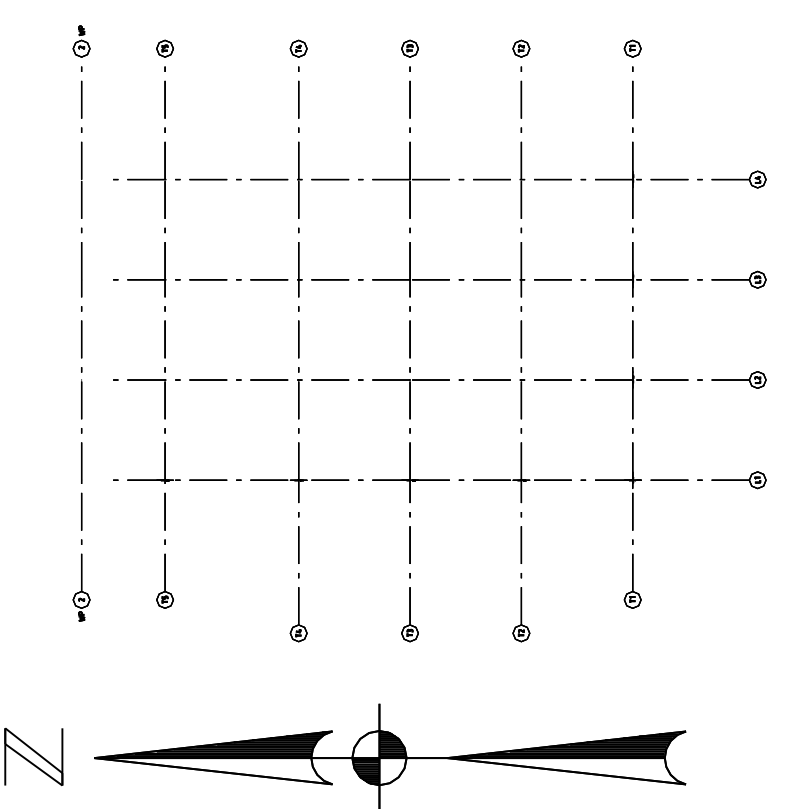

REV. No.	DESCRIPTION OF REVISION	ISSUE DATE	MADE BY	CHK'D BY	DISC. APPR.	PROJ. APPR.	CLIENT APPR.	REV. No.	DESCRIPTION OF REVISION	ISSUE DATE	MADE BY	CHK'D BY	DISC. APPR.	PROJ. APPR.	CLIENT APPR.
01	ISSUED FOR QL1 COMMENTS	04.12.00	OST	WH	WH			06	ISSUED FOR QL4	210901	OST	WH	WH		
02	ISSUED FOR QL1	22.12.00	OST	WH	WH			Z	AS-BUILT	100902	OST				
03	ISSUED AS UPDATED	020201	OHS	WH	WH			Z1	AS BUILT AFA-004046	08.03.13	JSA	MVR	JPP		
04	ISSUED FOR QL2	300301	OST	WH	WH										
05	ISSUED FOR QL3	070501	OST	WH	WH										

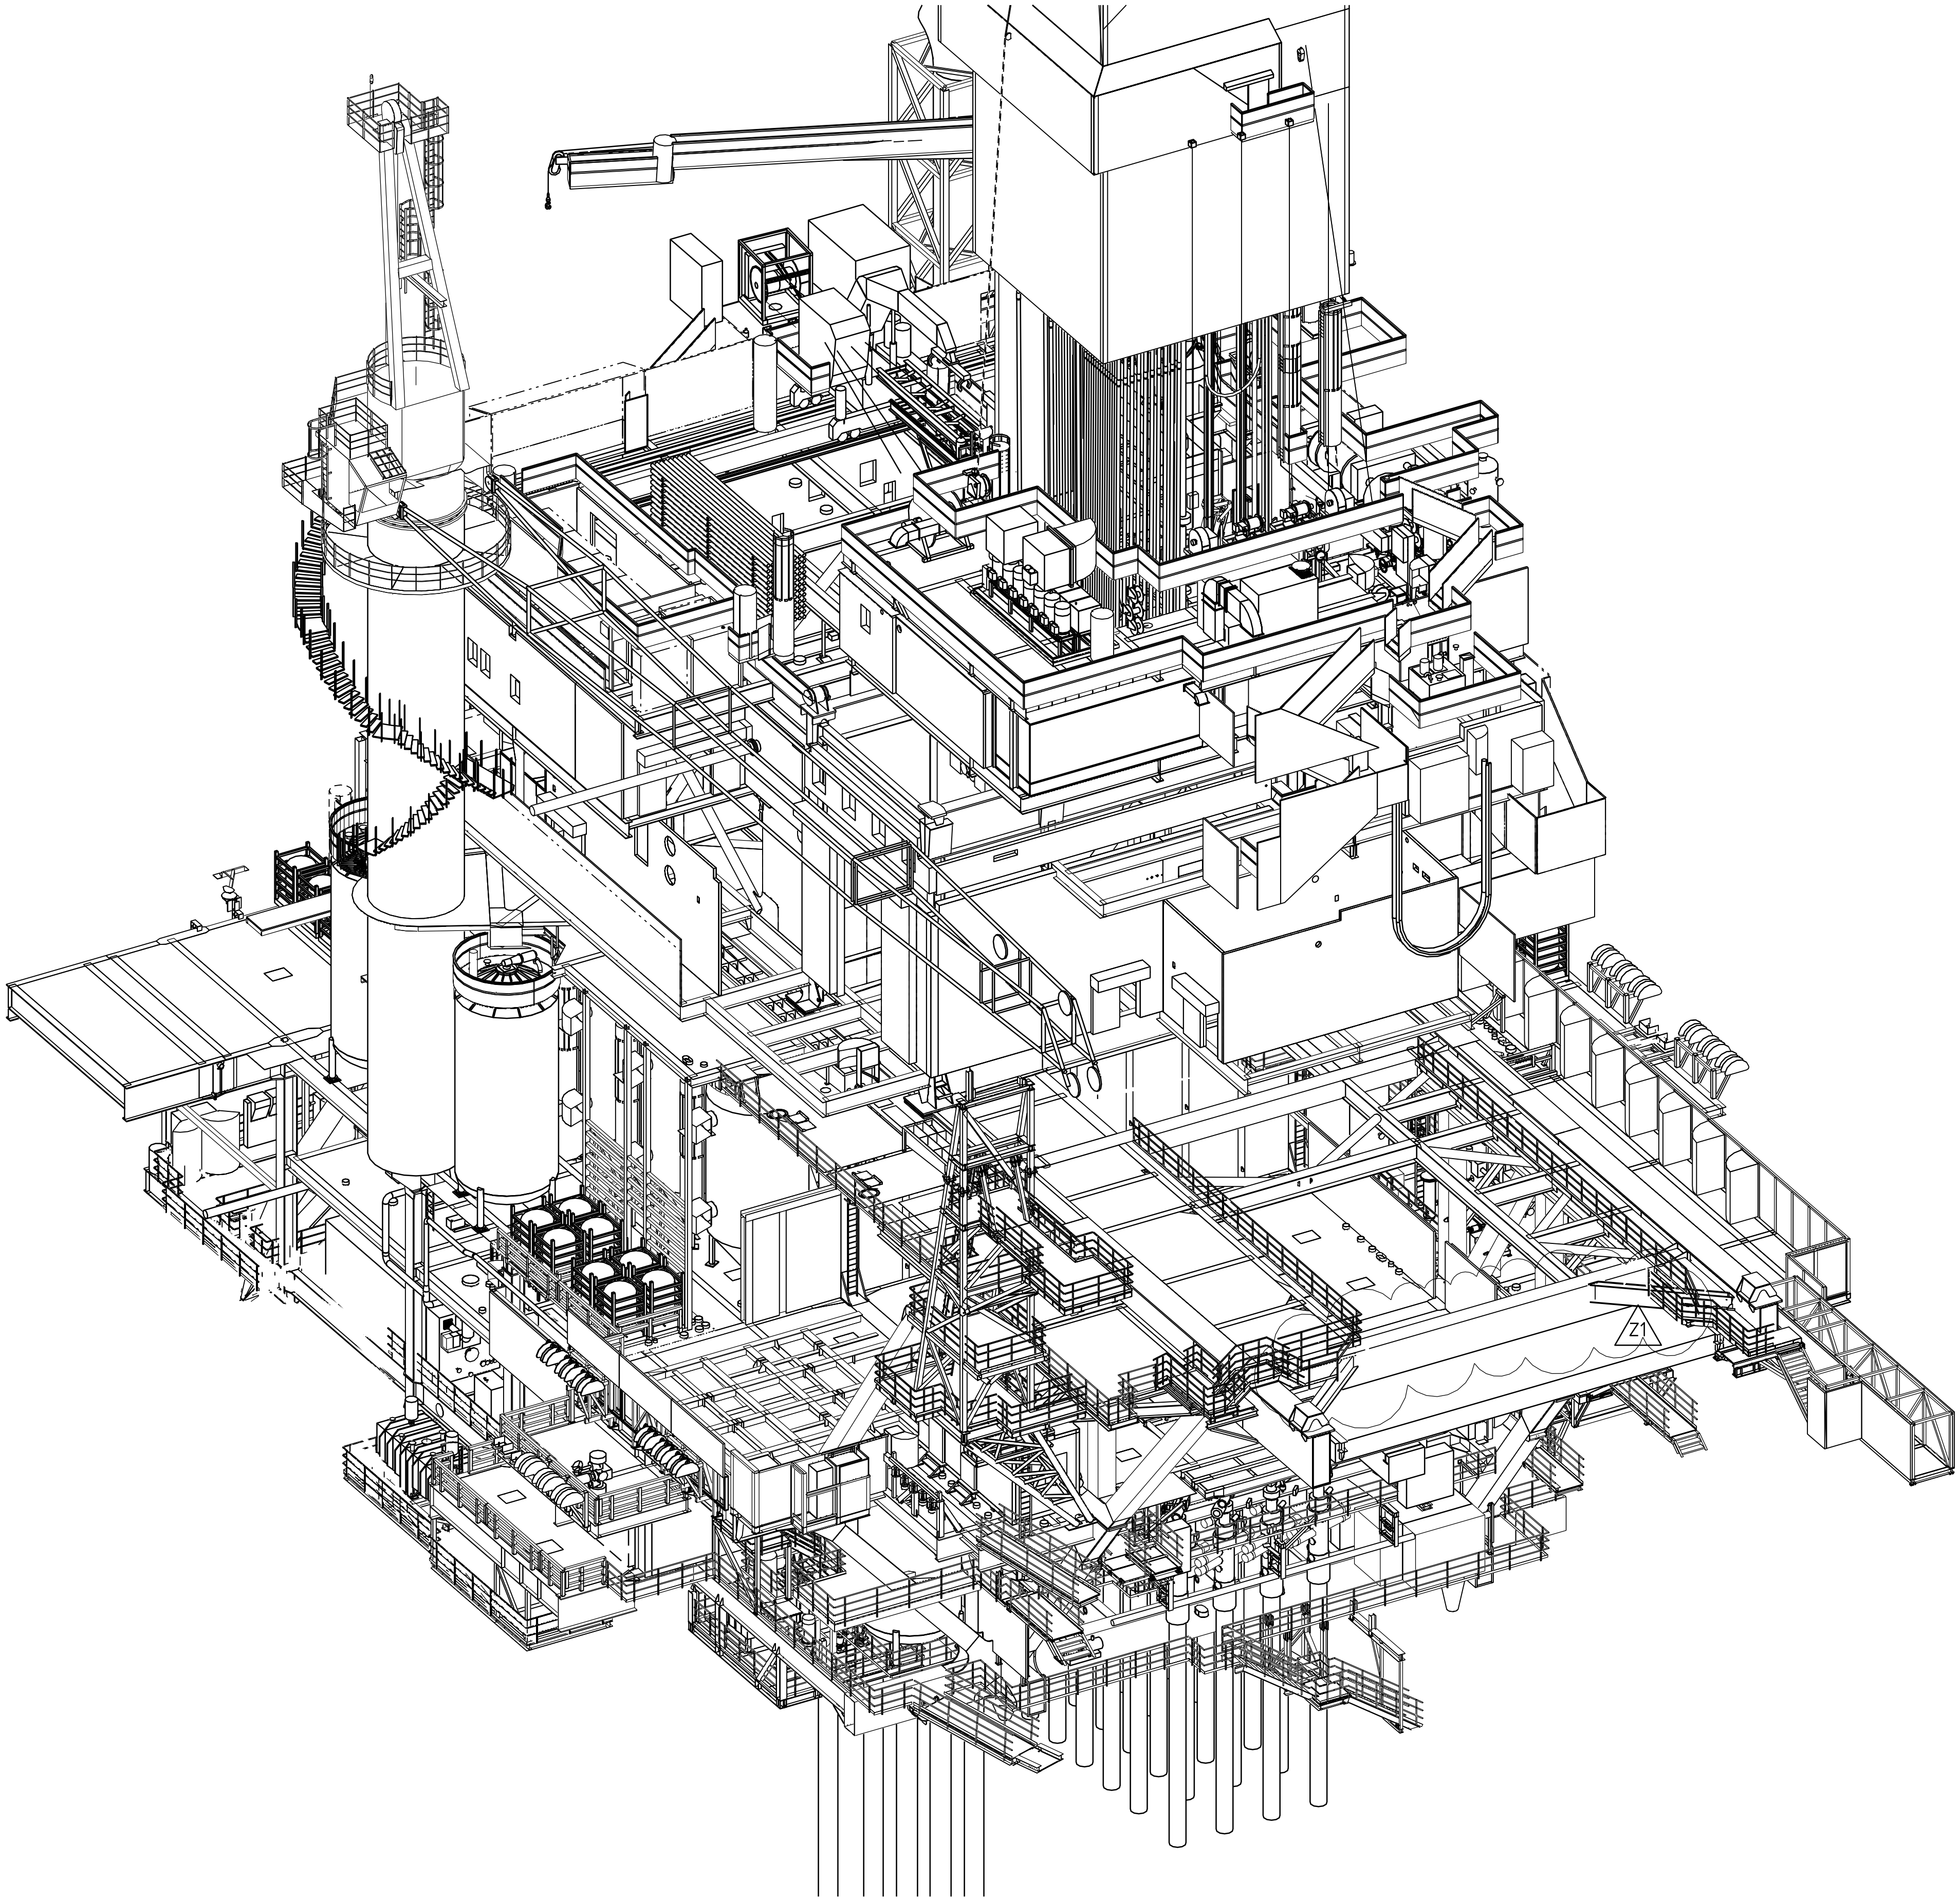

REF. DWG. No.	REF. DRAWING TITLE

	PLOT PLAN ISOMETRIC VIEW LOOKING SOUTH-WEST	DRAWING NO.				SCALE	
						1:150	
AREA	SYSTEM	TYPE	FACILITY CODE	ORIG.	DISP.	SEQ. No.	SHEET
A00	00	XE	IP	A0	L	0011	001
							REV. Z1