



PLATFORM NORTH

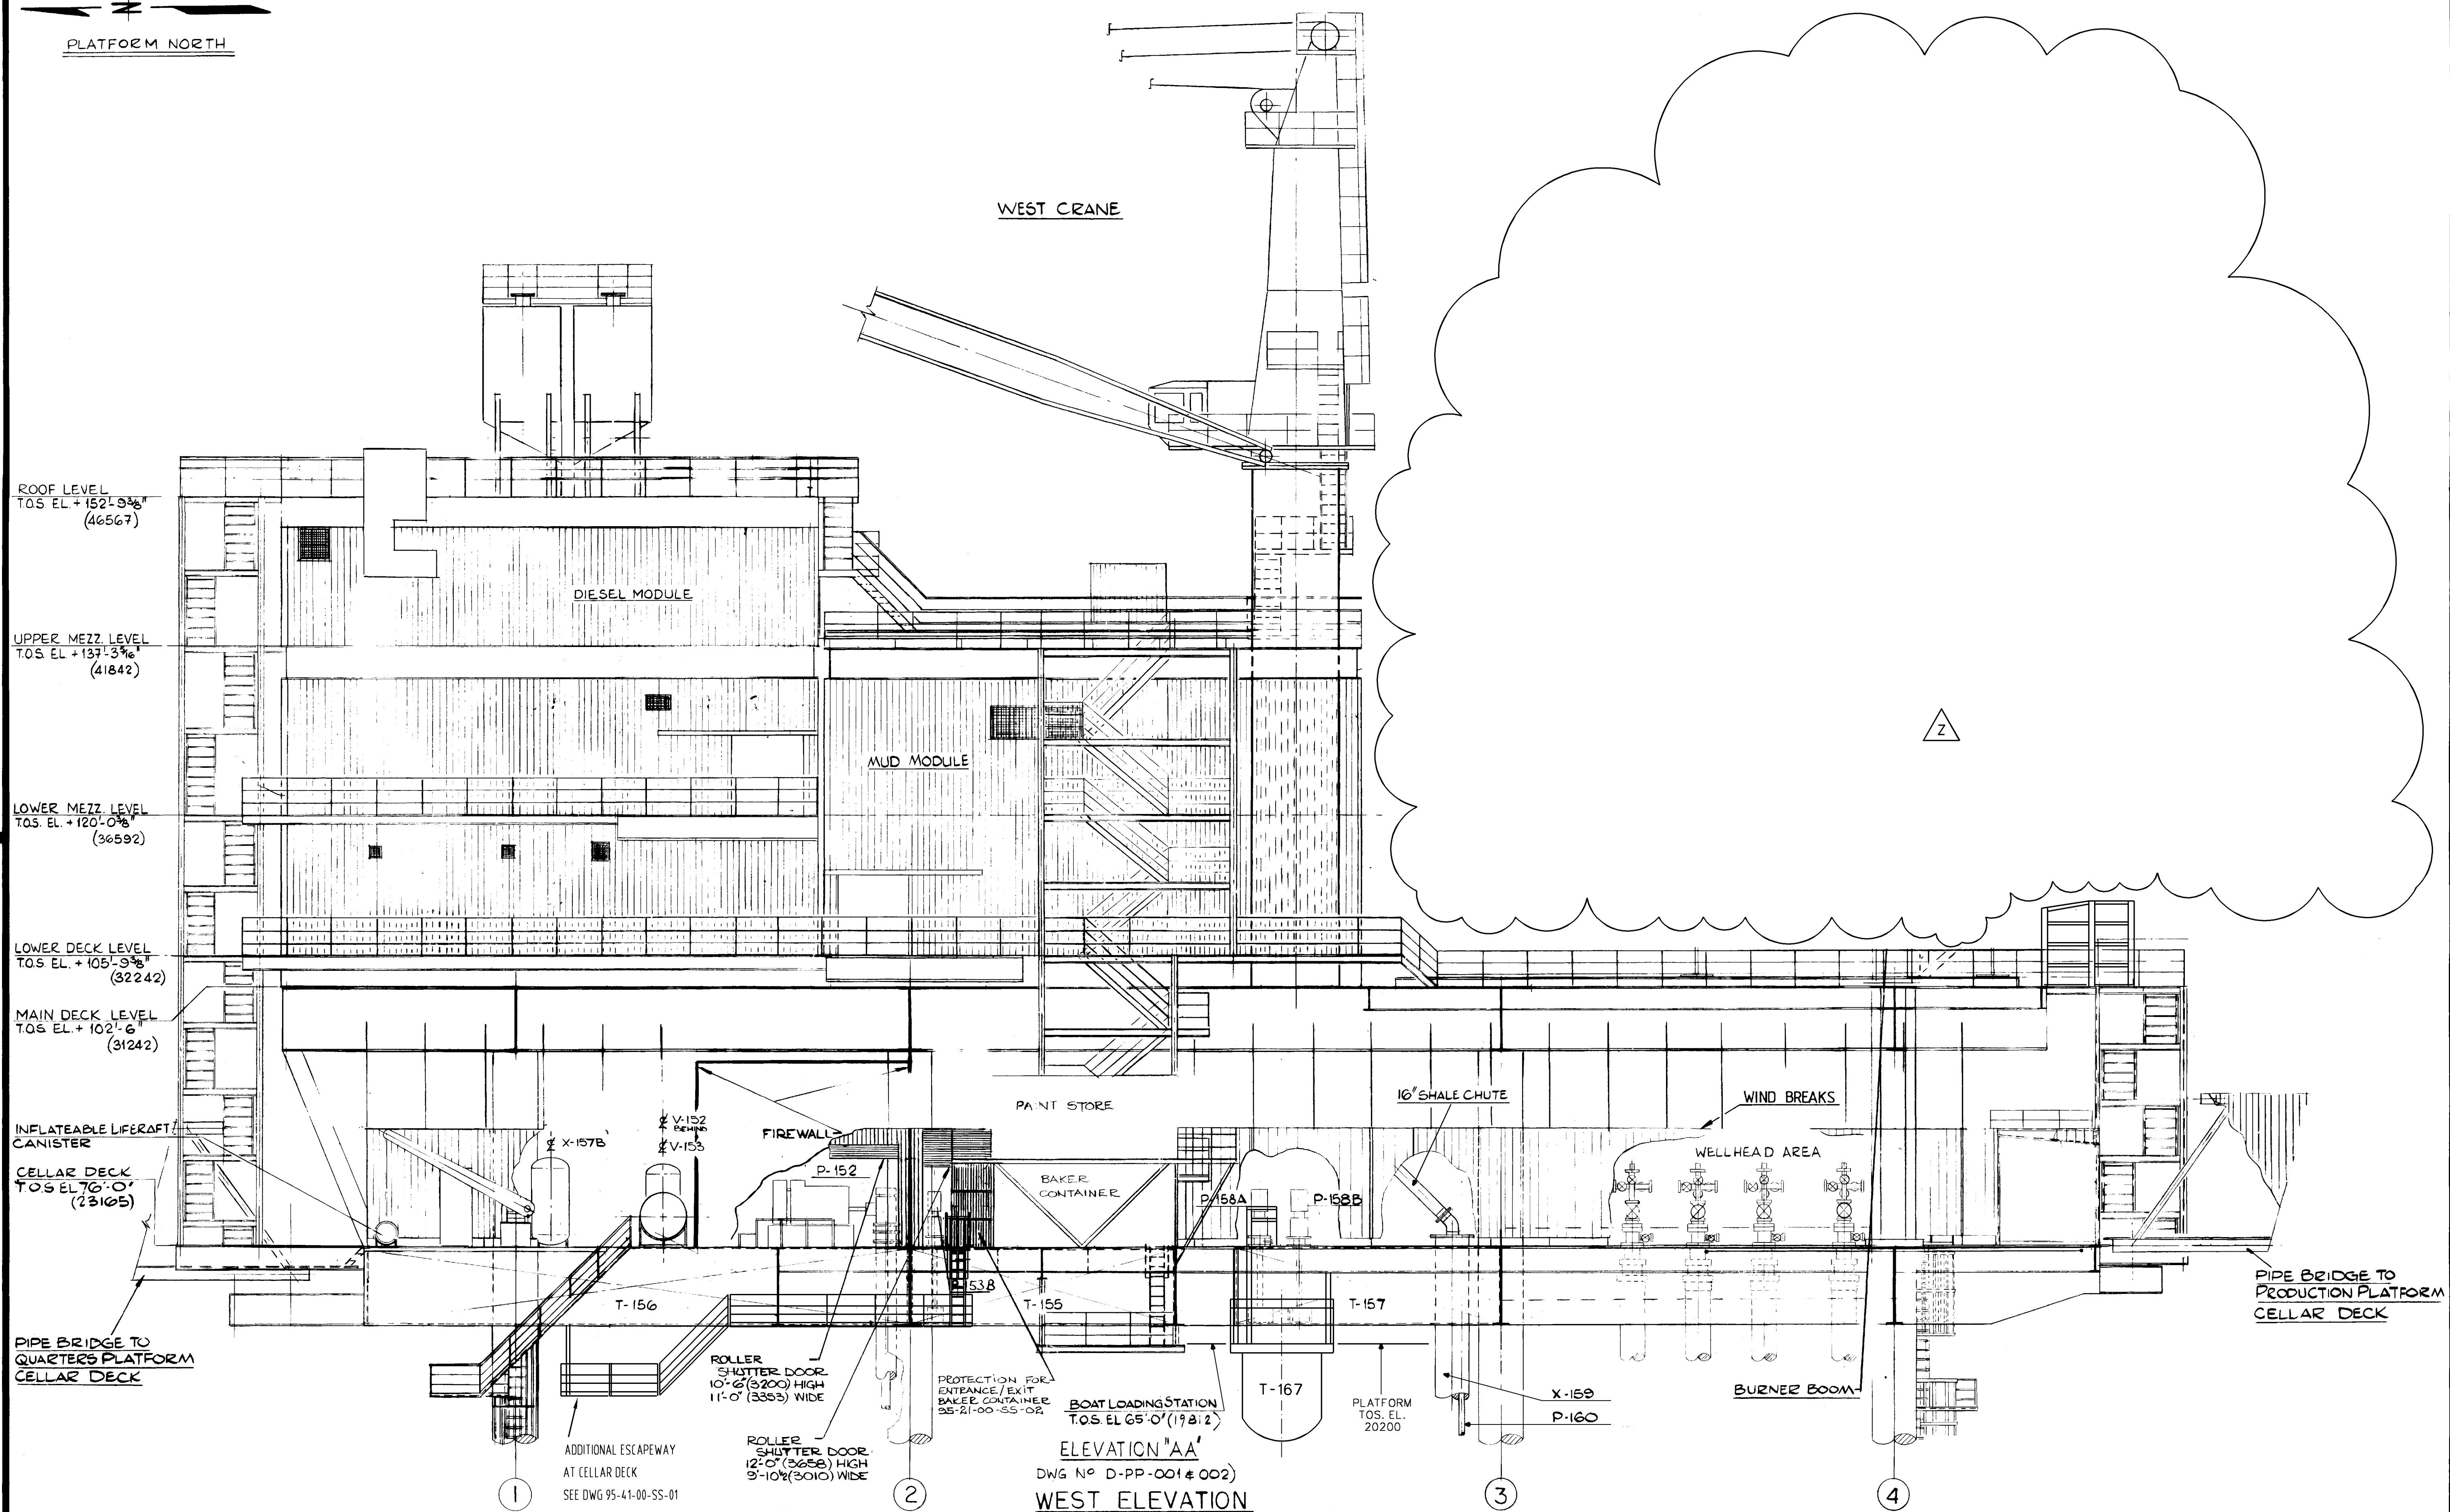

ELEVATION "AA"
DWG No D-PP-001 & 002
WEST ELEVATION

REV.	DESCRIPTION	DATE/SIGN.	DATE/SIGN.	REV.	DESCRIPTION	DATE/SIGN.	DATE/SIGN.
7	AS BUILT, AFA V3826	17.08.09	TMH/JVMH	4	DELETED CONTROL PANEL ROOM ADDED.	11/4/85 MA	ASB
6	AS BUILT	16.11.93	JB/F/S	3	PAINT STORE ADDED	26.03.85	ASB
5	CLADDING SOUTH/WEST CORNER			2	AS BUILT	5/10/83	ASB
4				1	ISSUE FOR CONSTRUCTION	15/6/79	ASB
3				0A	APPROVAL FOR CONSTRUCTION	6/6/79	DE
2				0	ISSUED FOR BID	15/3/79	DE
1							

Amoco Norway Oil Company



VALHALL DEVELOPMENT PROJECT
PHASE A - PROJECT No.554

Valhall Engineering Joint Venture

A/S AKERS MEK VERKSTED
BROWNAKER OFFSHORE A/S
KVÆRNER BRUG A/S

SCALE
1/8" = 1' FOOT

DATE
21-7-78

DRAWN BY
ODD PEDERSEN

CHECKED BY
CAMERON

ENG. APPROVED
PROJ. APPROVED

AMOCO APPROVED

TITLE: PLOT PLAN
WEST ELEVATION
DRILLING PLATFORM

DRAWING No.
D-PP-003

REV.
Z

SHEET 1 OF 1