

PLATFORM
NORTH

2
E121000

1B
E118400

1A
E102600

1
E100000

ROOF LEVEL
EL +81.637 T.O.S.

LEVEL 4
EL +77.378 T.O.S.

LEVEL 2
EL +73.267 T.O.S.

LEVEL 1
EL +68.987 T.O.S.

HV MODULE
EL +68.027 T.O.S.

4259

910

3352

2371

1006

FFL

762

4111

3353


2345

1006

4280

ROOF SLOPE
15800 225

ROOF LEVEL
EL +81.862 T.O.S.

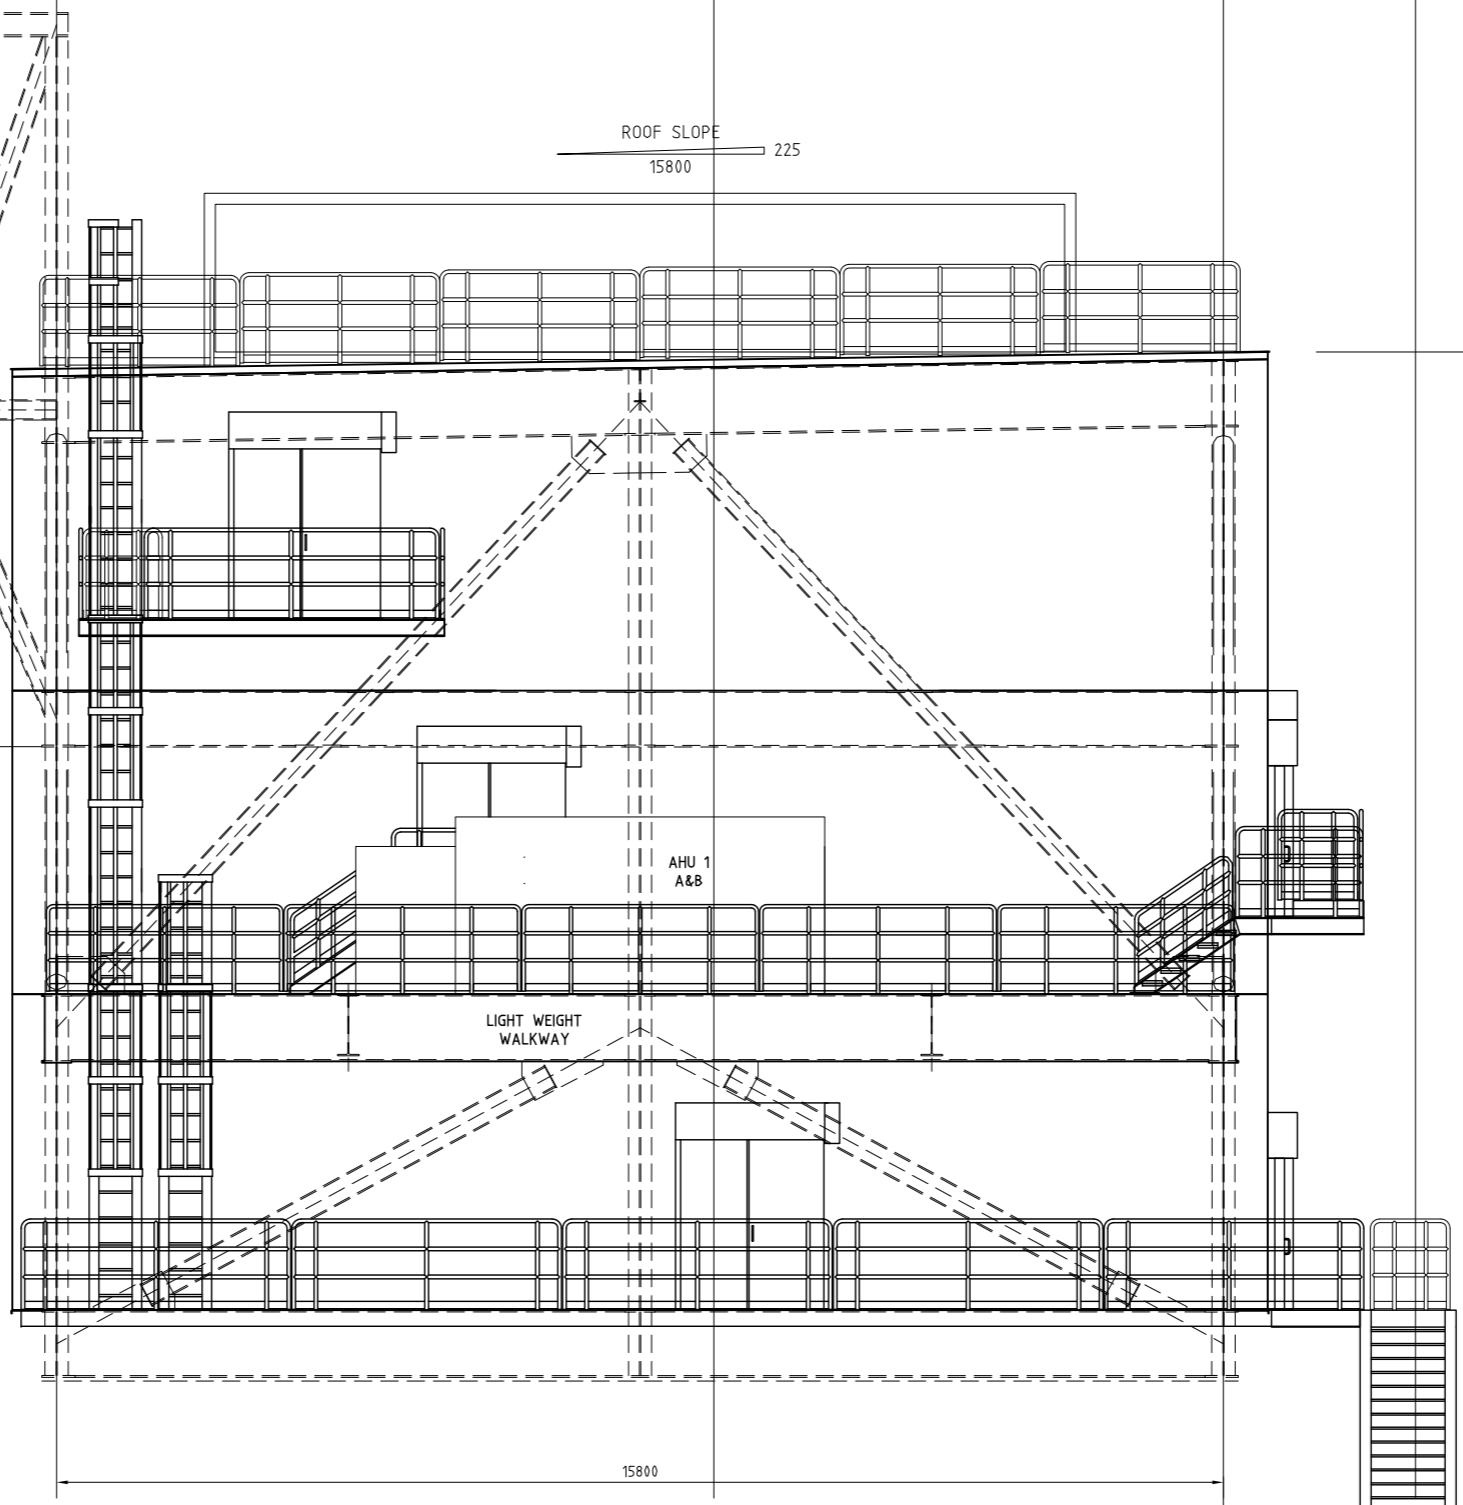

NORTH ELEVATION

REV. No.	DESCRIPTION OF REVISION	ISSUE DATE	MADE BY	CHK'D BY	DISC. APPR.	PROJ. APPR.	CLIENT APPR.	REV. No.	DESCRIPTION OF REVISION	ISSUE DATE	MADE BY	CHK'D BY	DISC. APPR.	PROJ. APPR.	CLIENT APPR.
0	ISSUED AFC	08.06.09	SC	AG	AG	CS									
E	RE ISSUED TO SUIT DCP-0720-C-288	12.08.08	SC	MW	JL	RW									
D	RE ISSUED TO SUIT DCP-0720-C-154	14.05.08	SC	JL	DH	JS									
C	RE ISSUED TO SUIT DCP-0720-C-148	08.05.08	SC	JL	DH	JS									
B	ISSUED FOR AFD / CLIENT REVIEW	28.04.08	SC	JL	RW	JS									
A	ISSUED FOR IDC	11.02.08	SC	RW	MW			Z	AS-BUILT	27.08.10	DA	SW	AG	CS	

VALHALL RE-DEVELOPMENT
PROJECT No. C06106



SLP ENGINEERING LTD
HAMILTON ROAD
LOWESTOFT
SUFFOLK, NR32 1XF

REFERENCE DRAWINGS:	DRAWING TITLE:
MS 00 XE	PH-LP-C-4318-002
MS 00 XE	PH-LP-C-4318-001
MS 00 XE	PH-LP-C-4317-002
MS 00 XE	PH-LP-C-4317-001
MS 00 XE	PH-LP-C-4316-001

POWER FROM SHORE
MODULE
NORTH ELEVATION

REGISTRATION CODES			DRAWING NO.				SCALE
AREA	SYSTEM	TYPE	FACILITY CODE	ORIG.	DISP.	SEQ. No.	SHEET
M5	00	XE	PH	LP	C	4315	001
							1:50
							REV. Z