

PLATFORM
NORTH

1

E100000

1A

E102600

1B

E184400

2

E121000

ROOF SLOPE
225
15800


ROOF LEVEL
EL +81.862 T.O.S.

ROOF LEVEL
EL +81.637 T.O.S.

LEVEL 3
EL +74.487 T.O.S.

LEVEL 1
EL +68.987 T.O.S.

HV MODULE
EL +68.027 T.O.S.

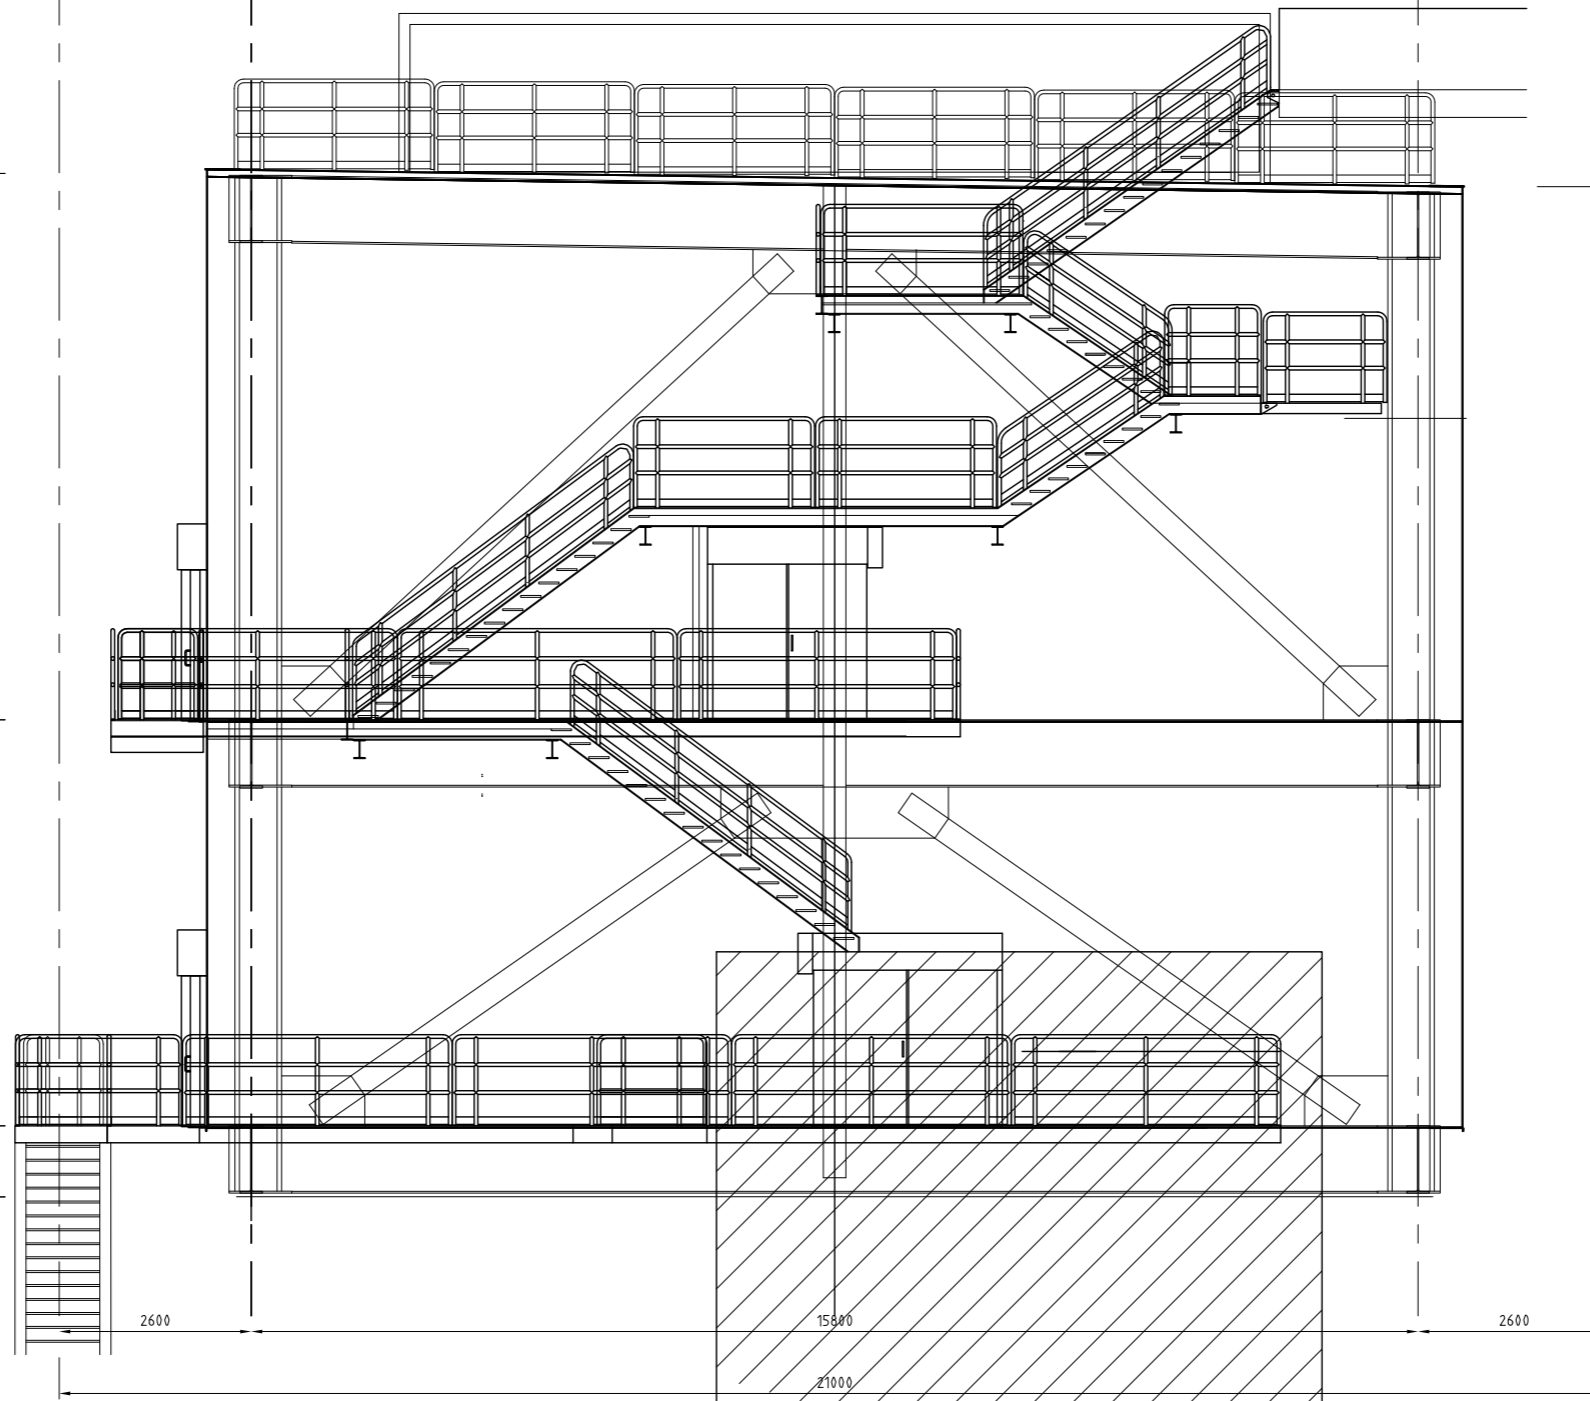

SOUTH ELEVATION

REV. No.	DESCRIPTION OF REVISION	ISSUE DATE	MADE BY	CHK'D BY	DISC. APPR.	PROJ. APPR.	CLIENT APPR.	REV. No.	DESCRIPTION OF REVISION	ISSUE DATE	MADE BY	CHK'D BY	DISC. APPR.	PROJ. APPR.	CLIENT APPR.
0	ISSUED AFC	08.06.09	SC	AG	AG	CS									
E	RE ISSUED TO SUIT DCP-0720-C-288	12.08.08	SC	MW	JL	RW									
D	RE ISSUED TO SUIT DCP-0720-C-154	14-05-08	SC	JL	DH	JS									
C	RE ISSUED TO SUIT DCP-0720-C-148	08.05.09	SC	JL	DH	JS									
B	ISSUED AFD / CLIENT REVIEW	08.04.08	SC	JL	RW	JS									
A	ISSUED FOR IDC	11.02.08	SC	RW	RW	JS	Z	AS-BUILT	27.08.10	DA	SW	AG	CS		

VALHALL RE-DEVELOPMENT
PROJECT No. C06106



SLP ENGINEERING LTD
HAMILTON ROAD
LOWESTOFT
SUFFOLK, NR32 1XF

REFERENCE DRAWINGS:

MS 00 XE	PH-LP-C-4318-002
MS 00 XE	PH-LP-C-4318-001
MS 00 XE	PH-LP-C-4317-002
MS 00 XE	PH-LP-C-4317-001
MS 00 XE	PH-LP-C-4315-001

DRAWING TITLE:



POWER FROM SHORE
MODULE
SOUTH ELEVATION

REGISTRATION CODES

AREA	SYSTEM	TYPE
M5	00	XE

DRAWING NO.

FACILITY CODE	ORIG.	DISP.	SEQ. No.	SHEET
PH	LP	C	4316	001

SCALE

1:50

REV.

Z