


PLATFORM NORTH

NOTES

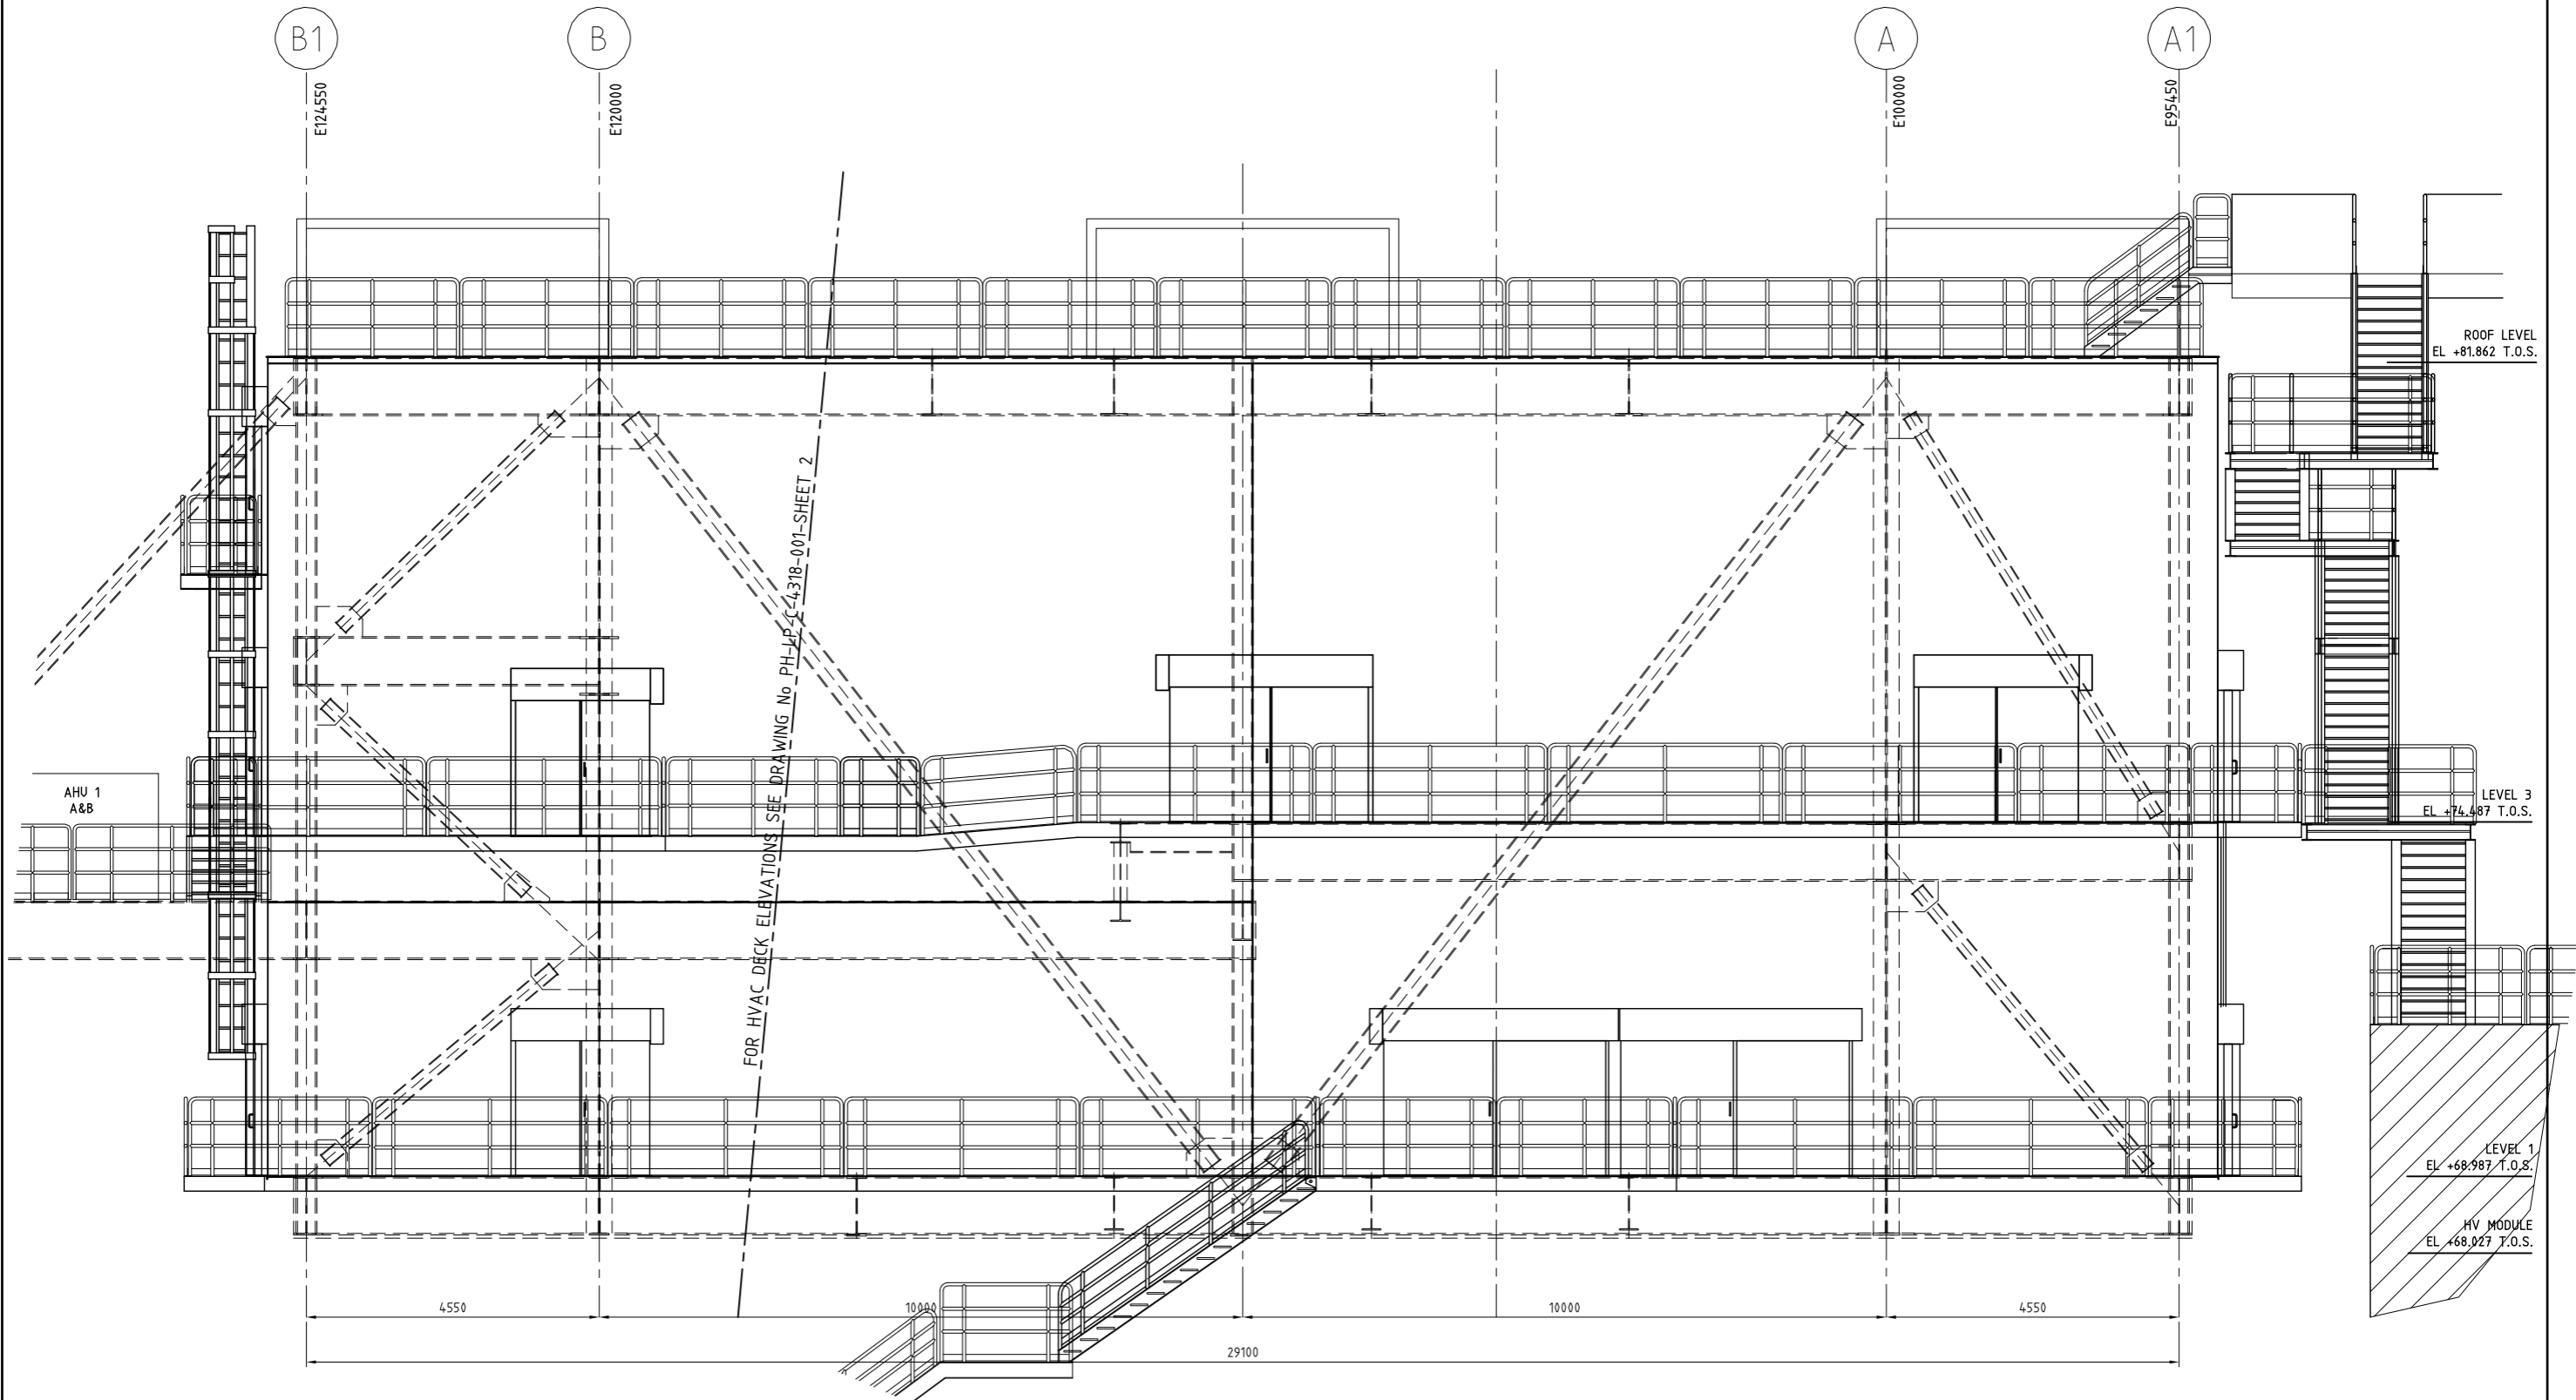

WEST ELEVATION

REV. No.	DESCRIPTION OF REVISION	ISSUE DATE	MADE BY	CHK'D BY	DISC. APPR.	PROJ. APPR.	CLIENT APPR.	REV. No.	DESCRIPTION OF REVISION	ISSUE DATE	MADE BY	CHK'D BY	DISC. APPR.	PROJ. APPR.	CLIENT APPR.
F	RE ISSUED TO SUIT DCP-0720-C-327	04.09.08	SC	MW	PS	RW									
E	RE ISSUED TO SUIT DCP-0720-C-288	12.08.08	SC	MW	JL	RW									
D	RE ISSUED TO SUIT DCP-0720-C-154	14.05.08	SC	JL	DH	JS									
C	RE ISSUED TO SUIT DCP-0720-N-141	07.05.08	SC	JL	DH	JS									
B	ISSUED FOR AFD CLIENT REVIEW	28.04.08	SC	JL	RW	JS	Z	AS-BUILT	27.08.10	DA	SW	AG	CS		
A	ISSUED FOR IDC	11.02.08	SC	RW	MW		0	ISSUED AFC	08.06.09	SC	AG	AG	CS		

VALHALL RE-DEVELOPMENT
PROJECT No. C06106



REFERENCE DRAWINGS:	DRAWING TITLE:
MS 00 XE	PH-LP-C-4318-002
MS 00 XE	PH-LP-C-4317-002
MS 00 XE	PH-LP-C-4317-001
MS 00 XE	PH-LP-C-4316-001
MS 00 XE	PH-LP-C-4315-001

POWER FROM SHORE
MODULE
WEST ELEVATION

REGISTRATION CODES			DRAWING NO.				SCALE
AREA	SYSTEM	TYPE	FACILITY CODE	ORIG.	DISP.	SEQ. No.	SHEET
M5	00	XE	PH	LP	C	4318	001
							1:50
							REV. Z