


| EQUIPMENT     | DESCRIPTION              |
|---------------|--------------------------|
| 48-SS-12001   | FIRE MONITOR             |
| 48-SQ-12001 I | FIRE WATER HOSEREEL West |
| 48-SQ-12001 J | FIRE WATER HOSEREEL East |

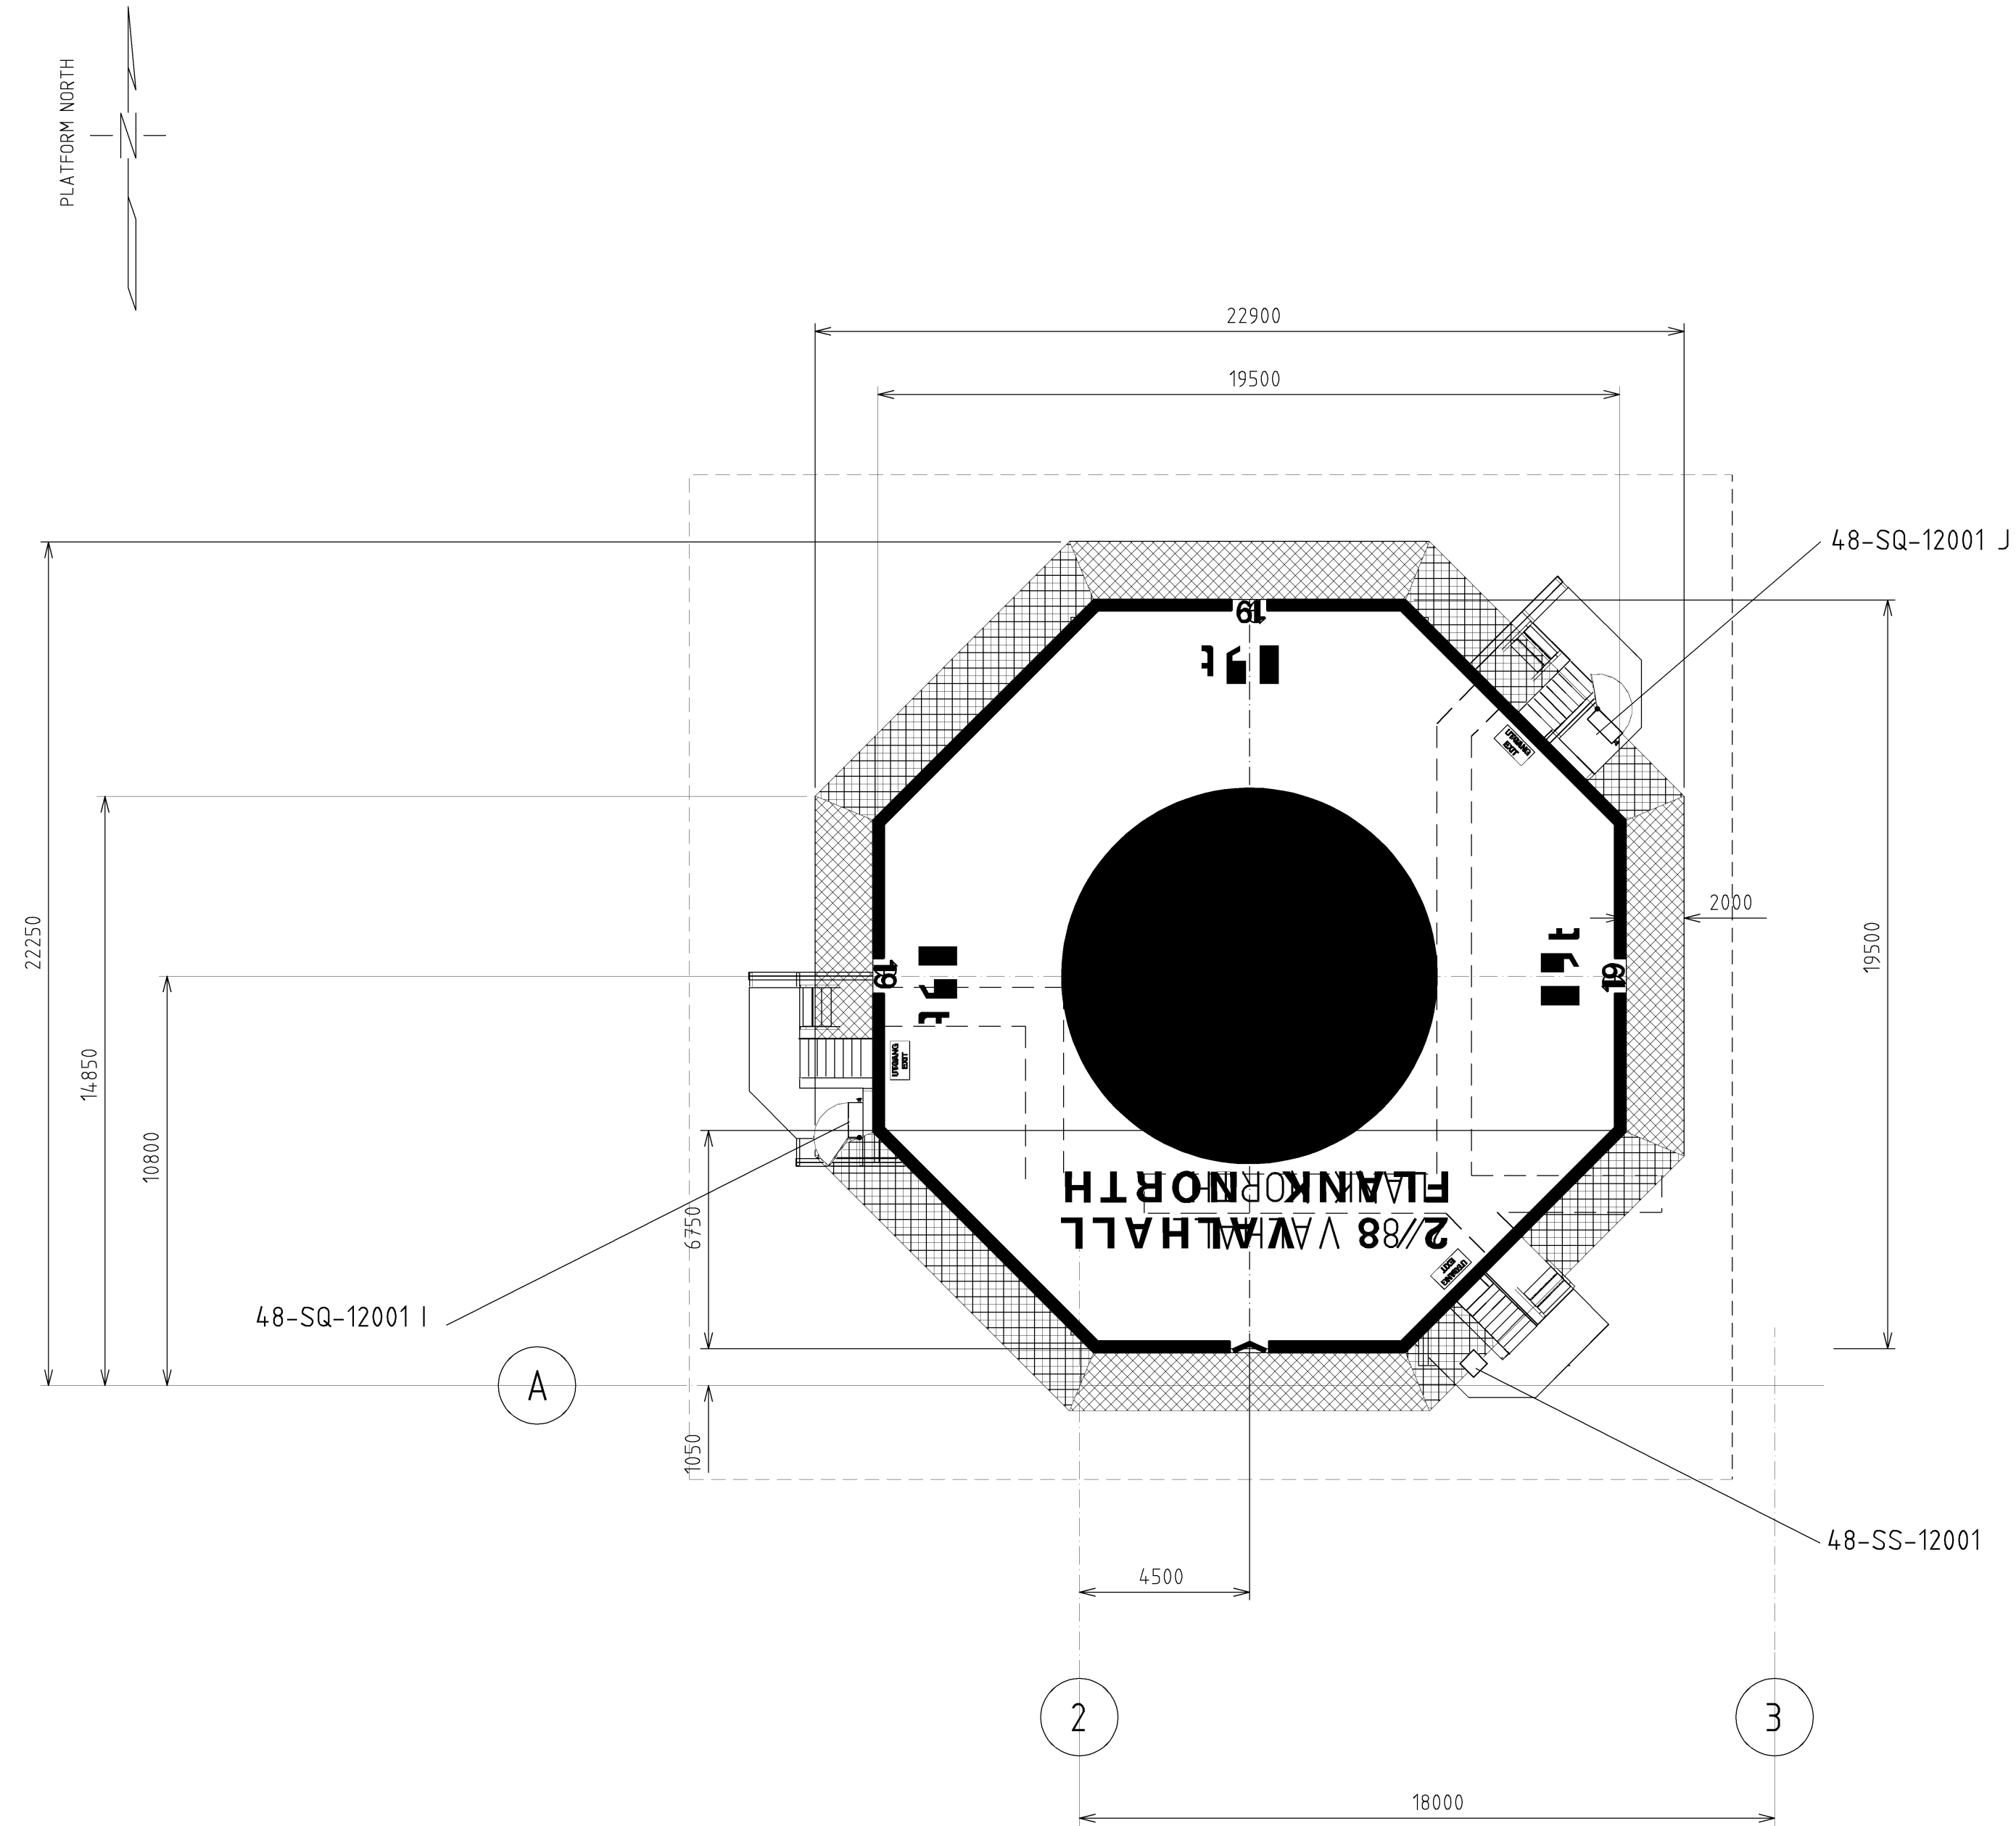


PLAN VIEW HELI DECK EL. 43.000

| REV No | DESCRIPTION OF REVISION | ISSUE DATE | MADE BY | CHK'D BY | DISC APPR | PROJ APPR | CLIENT APPR |
|--------|-------------------------|------------|---------|----------|-----------|-----------|-------------|
| Z      | AS BUILT                | 01 09 03   | TR      |          |           |           |             |







|   |        |   |          |
|---|--------|---|----------|
|  |        | 2/8 VALHALL FLANK NORTH<br>PLOT PLAN HELI DECK<br>PLAN VIEW<br>EL. 43.000 |          |
| REGISTRATION CODES  |        | DRAWING NO.   |          |
| AREA  | SYSTEM | FACILITY CODE   | ORIG     |
| W00   | 00     | FN - HT - L - 000001-001  | L        |
| TYPE  | DISP   | SEQ. No   | SHEET    |
| XF  |        |   | A1 1:100 |
|   |        |   | SCALE    |
|   |        |   | REV      |
|   |        |   | Z        |