


EQUIPMENT	DESCRIPTION
43-XR-12002	HYPOCHLORITE DOSING UNIT
47-SZ-12001 C	SAFETY SHOWER CABINET
47-TB-12001 A	FRESH WATER TANK A
47-TB-12001 B	FRESH WATER TANK B
48-SM-12002	DIFF SKID
48-SS-12002	FIRE WATER MONITOR
48-SQ-12001 C / F / K	FIRE WATER HOSE REEL
48-SZ-12002	FIREMANS EQUIPMENT
75-SC-12001 A	SAFETY CABINET
76-SZ-12001	SAFETY EQUIPMENT CABINET
90-MA-12001	PEDESTAL CRANE
90-MA 12002	SIMOPS CRANE
92-MU-12001	HOSE LOADING STATION
43-TG-121026	SUMP, DRIP TRAY
	TANK (4500 litre), TOTE
47-SZ-12001D	SAFETY SHOWER & EYEWASH
	OXYGEN SCAVANGER TOTE TANK
	SCALE INHIBITOR TOTE TANK
	SCALE INHIBITOR TOTE TANK
	BIOCIDE TOTE TANK
	NITROGEN BOTTLE RACK
	NITROGEN BOTTLE RACK

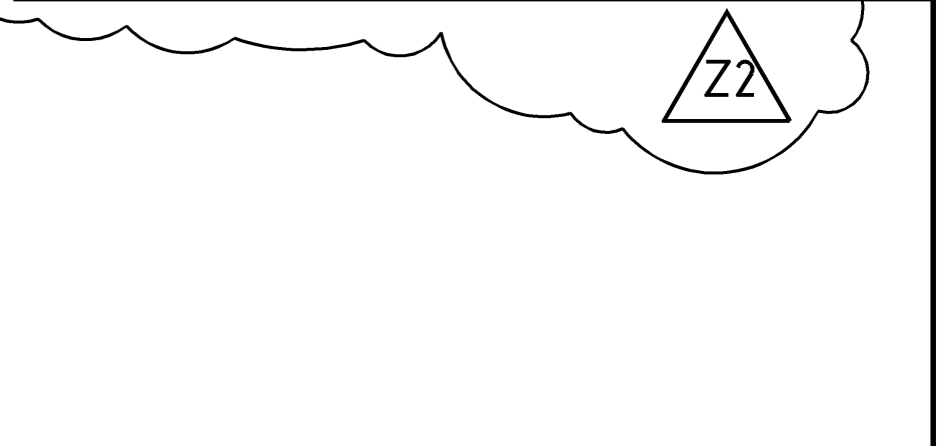

NOTE: WIND WALLS ON NORTH AND WEST PLATFORM EDGES

GLOBAL DATUM POINT  
E 521810  
N 242377

REV No	DESCRIPTION OF REVISION	ISSUE DATE	MADE BY	CHKD BY	DISC APPR	PROJ APPR	CLIENT APPR
Z2	ASBUILT VAFA-003573	30 11 11	SS	JC	JC		
Z1	AS BUILT, AFA-3539	10 05 07	KSI	GBH		HEK	HEK
Z	AS BUILT	01.09.03	T.R				

future engineering as

FABRICATION  
HEEREMA  
TØNSBERG A.S.

OIL & GAS

2/8 VALHALL FLANK NORTH  
PLOT PLAN MAIN DECK  
PLAN VIEW  
EL. 34.000

REGISTRATION CODES			DRAWING NO				SCALE
AREA	SYSTEM	TYPE	FACILITY CODE	ORIG	DISP	SEQ No	SHEET
W00	00	XF	FN - HT - L -	000002 -	001		Z2

**PLAN VIEW MAIN DECK EL. 34.000**