


EQUIPMENT	DESCRIPTION
11-VA-12001	SEPARATOR
31-VD-12001	VENT KNOCK-OUT & DRAIN DRUM
40-TA-12001	DIESEL STORAGE TANK (INSIDE PEDESTAL)
47-SZ-12001 C	SAFETY SHOWER CABINET
47-TB-12001 A	FRESH WATER TANK A
47-TB-12001 B	FRESH WATER TANK B
48-SM-12001	AFFF SKID
48-SS-12001	FIRE MONITOR
48-SQ-12001 C/I	HOSE STATION
81-TG-12001	DRILLING SPILL SUMP / OPEN DRAIN TANK
81-VD-12001	RECLAIMED OIL SUMP
90-MA-12001	MAIN PLATFORM PEDESTAL CRANE
90-MA-12003 A	TRANSVERS BEAM CRANE A
90-MA-12003 B	TRANSVERS BEAM CRANE B
92-MU-12001	HOSE LOADING STATION
47-SZ-12001 D	SAFETY SHOWER & EYE WASH

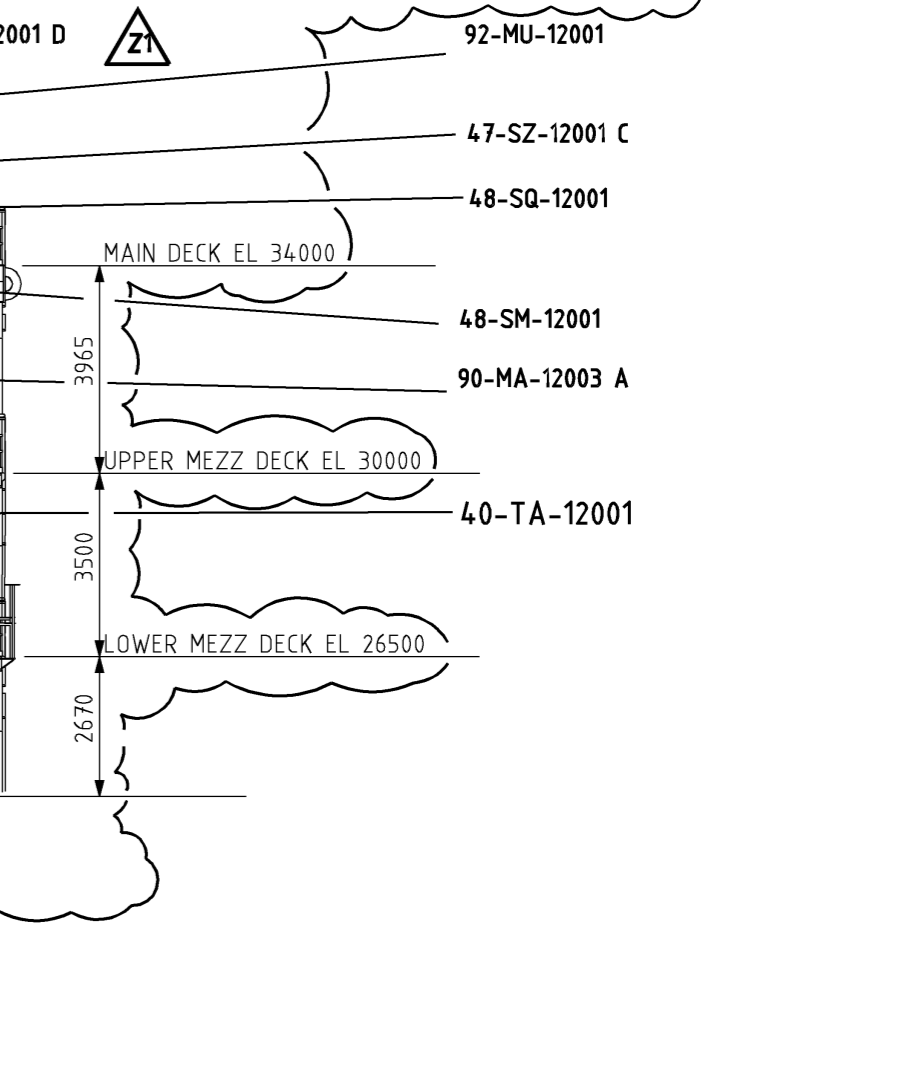

REV No	DESCRIPTION OF REVISION	ISSUE DATE	MADE BY	CHK'D BY	DISC APPR	PROJ APPR	CLIENT APPR
Z1	AS BUILT VAFA-003573	30.11.11	SS	JC	JC		
Z	AS BUILT	01.09.03	TR				

2/8 VALHALL FLANK NORTH
PLOT PLAN
SECTION LOOKING NORTH

REGISTRATION CODES			DRAWING NO				SCALE
AREA	SYSTEM	TYPE	FACILITY CODE	ORIG	DISP	SEQ No	SHEET
W00	00	XF	FN - HT - L-000007-	001			
							1:100
							REV Z1

SECTION LOOKING NORTH