

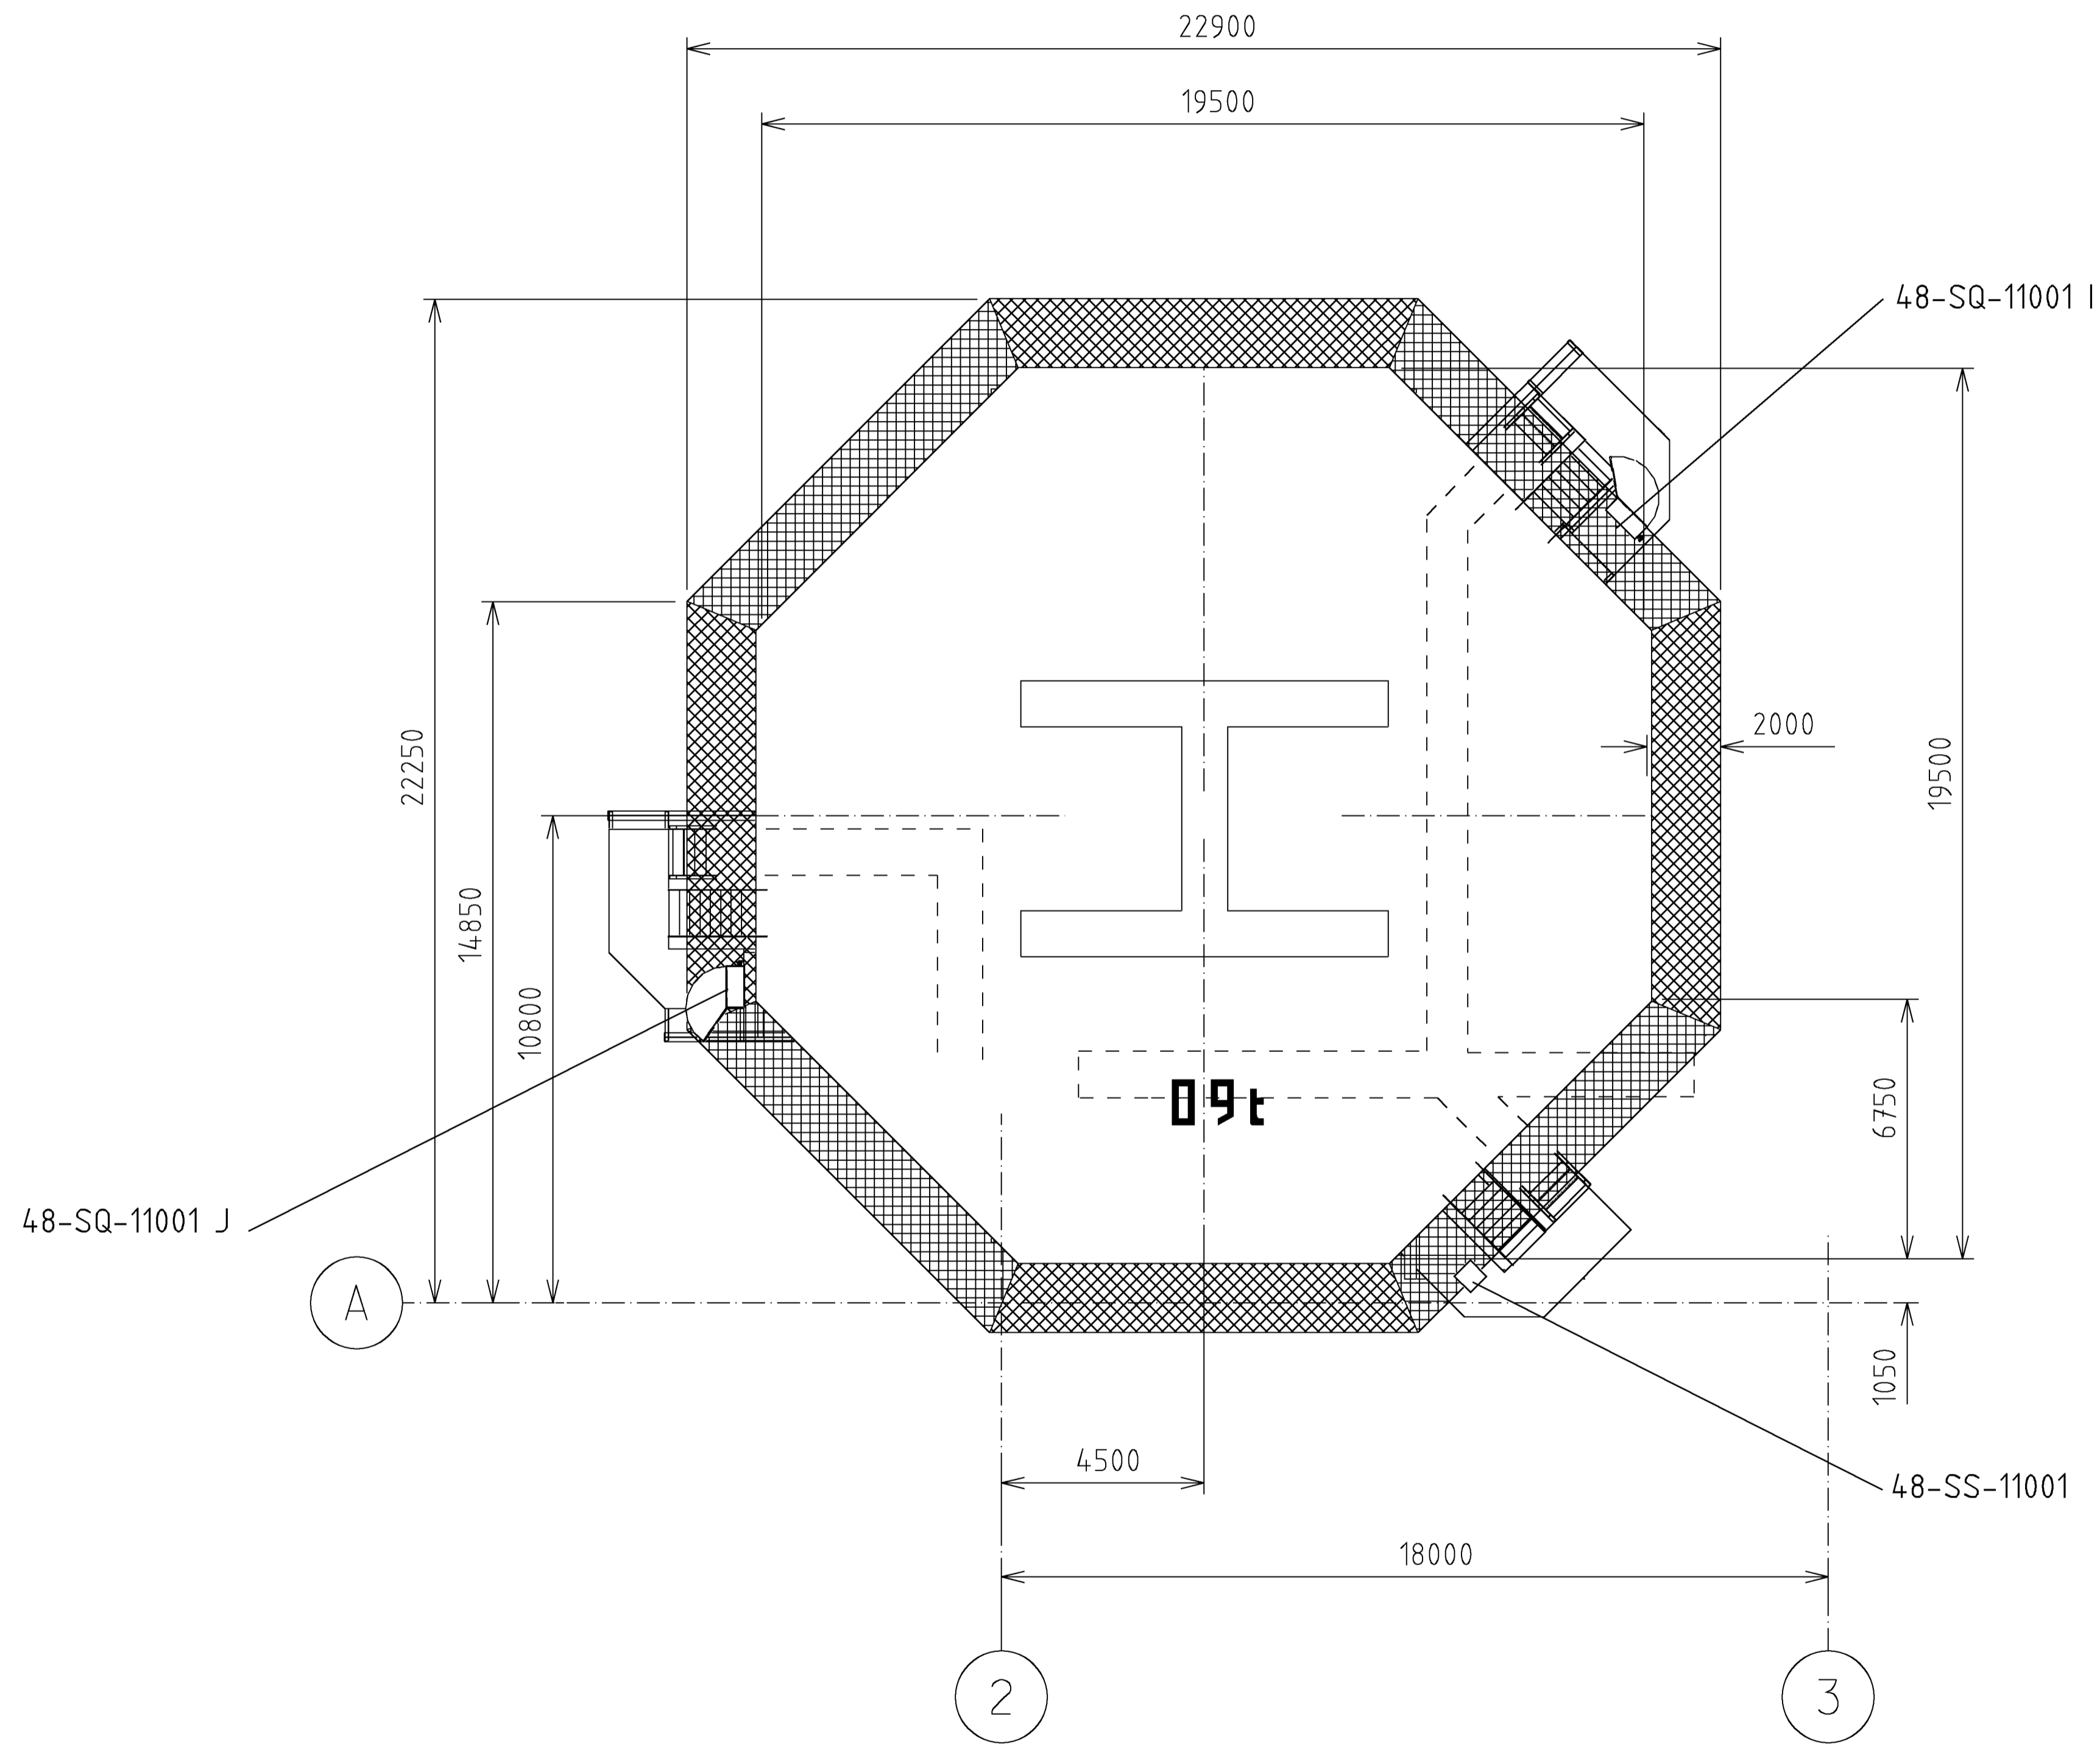
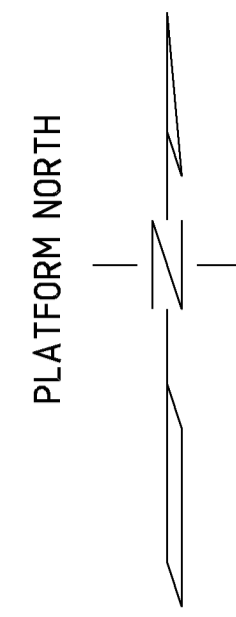


EQUIPMENT	DESCRIPTION
48-SS-11001	FIRE MONITOR
48-SQ-11001 J	FIRE WATER HOSEREEL West
48-SQ-11001 I	FIRE WATER HOSEREEL East

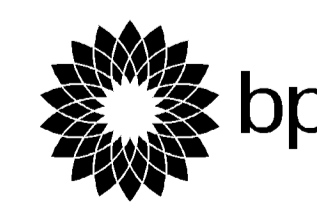

**PLAN VIEW HELI DECK EL. 43.000**

REV No	DESCRIPTION OF REVISION	ISSUE DATE	MADE BY	CHKD BY	DISC APPR	PROJ APPR	CLIENT APPR
Z	AS BUILT	16.10.02					

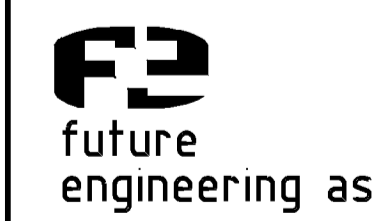

2/11 VALHALL FLANK SOUTH  
PLOT PLAN HELI DECK  
PLAN VIEW  
EL. 43.000

REGISTRATION CODES			DRAWING NO				SCALE
AREA	SYSTEM	TYPE	FACILITY CODE	ORIG	DISP	SEQ No	SHEET
W00	00	XF	FS - HT - L-	000001-001			

REV	SCALE
Z	A1 1:100