


EQUIPMENT	DESCRIPTION
11-VA-11001	SEPARATOR
31-VD-11001	VENT KNOCK-OUT CLOSED DRAIN DRUM
40-TA-11001	DIESEL STORAGE TANK (INSIDE PEDESTAL)
43-XR-11001	CHEMICAL INJECTION SKID
47-SZ-11001 C	SAFETY SHOWER CABINET
47-TB-11001 A	FRESH WATER TANK A
47-TB-11001 B	FRESH WATER TANK B
48-SM-11002	DIFF SKID
48-SS-11001	FIRE MONITOR
48-SQ-11001 C/F/K/I/J	FIRE WATER HOSE REEL
81-TG-11001	DRILLING SPILL SUMP / OPEN DRAIN TANK
81-VD-11001	RECLAIMED OIL SUMP
90-MA-11001	MAIN PLATFORM PEDESTAL CRANE
90-MA-11002	SIMOPS CRANE
90-MA-11003 A	TRANSVERS BEAM CRANE A
90-MA-11003 B	TRANSVERS BEAM CRANE B
92-MU-11001	HOSE LOADING STATION
47-SZ-11001 D	SAFETY SHOWER & EYE WASH

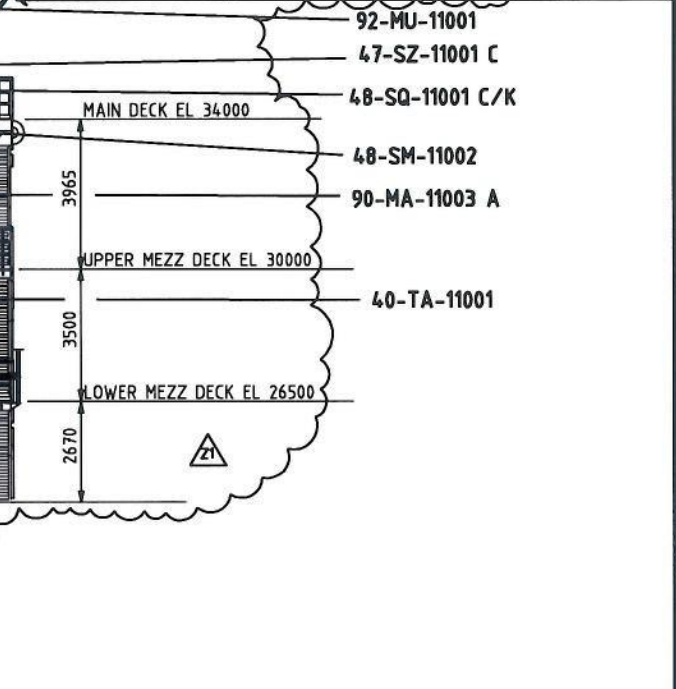

REV No	DESCRIPTION OF REVISION	ISSUE DATE	MADE BY	CHK'D BY	DISC APPR	PROJ APPR	CLIENT APPR
Z1	AS BUILT VAFA-003572-SM	15 06 11	ELH	IJW			SGL
Z	AS BUILT	16 10 02					

2/11 VALHALL FLANK SOUTH
PLOT PLAN
SECTION LOOKING NORTH

REGISTRATION CODES			DRAWING NO.				SCALE
AREA	SYSTEM	TYPE	FACILITY CODE	ORG	DEP	DES No	SHEET
W00	00	XF	FS	HT	L	000007	001

SCALE: 1:100
REV: Z1

SECTION LOOKING NORTH