


TWO RING STIFFENERS
SEE DRG. -N-9121-01
LEG A1 AND A2
TOTAL 4 NO OFF

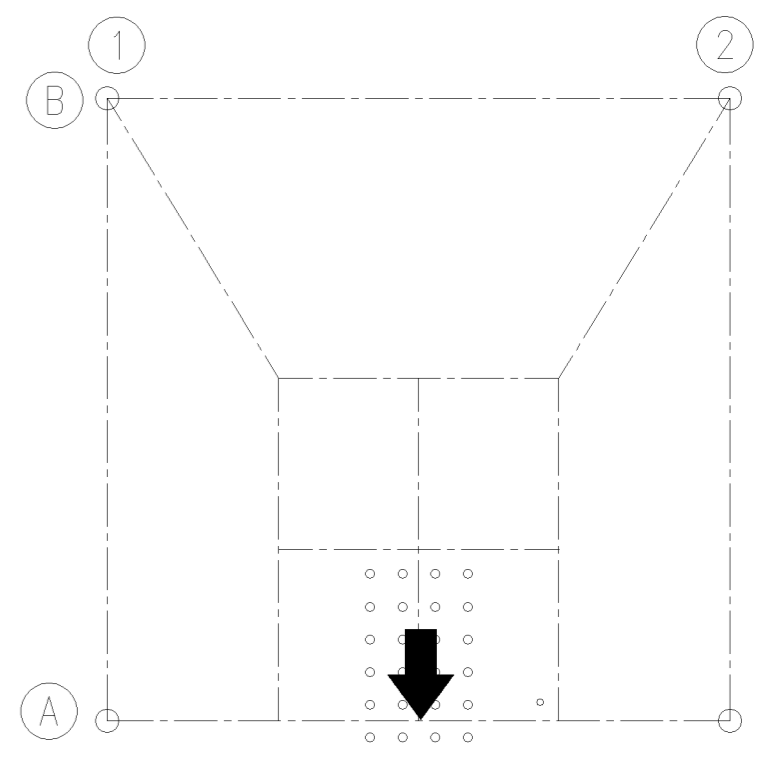


WEIGHT/VEKT:

NOTES:

1. FOR GENERAL NOTES AND STANDARD ABBREVIATIONS SEE DRG. IP-AO-N-9002-01
2. FOR WELDS AND STANDARD DETAILS SEE DRG. IP-AO-N-9021-01 & IP-AO-N-9022-01
3. MATERIAL NORSOK MDS Y30 (420-I)
4. OFFSETS AND LENGTHS ALONG CENTER LINE OF LEG

REF. NO	SHOP DRAWING	DESIGN DRAWING
REFERENCE		

REV	ISSUE DATE	DESCRIPTION	REF. NO	DRAWN BY	CHK'D BY	APPR. DISC.	APPR. CONTR.
Z	12.09.2002	ISSUED FOR ASBUILT		NCA	TKT	TA	
03	15.05.01	ISSUED FOR CONSTRUCTION		MR	TKT	JH	
02	15.03.01	ISSUED FOR MTO 1		JG	TKT	JH	
01	22.12.00	ISSUED FOR CONCEPT FREEZE		TRH	TKT	JH	

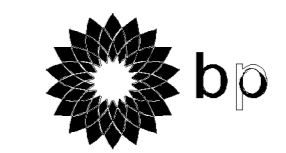

IP-AO-N-9101-001_Z Valhall Water Injection Jacket			
SECTION NO.		CADFILE NAME	
N	XG	J00	
DISC. CODE	INFO TYPE	AREA CODE	FUNC. CODE
1:500 SCALE	A3 SIZE	96 SYSTEM CODE	AV ORG. CODE
IP-AO-N-9101 DOCUMENT NO		001 SHEET	Z REV
		STATUS	

DRAWN BY/TELEPHONE XXXXXXXXXX TEL.: XXXXXX