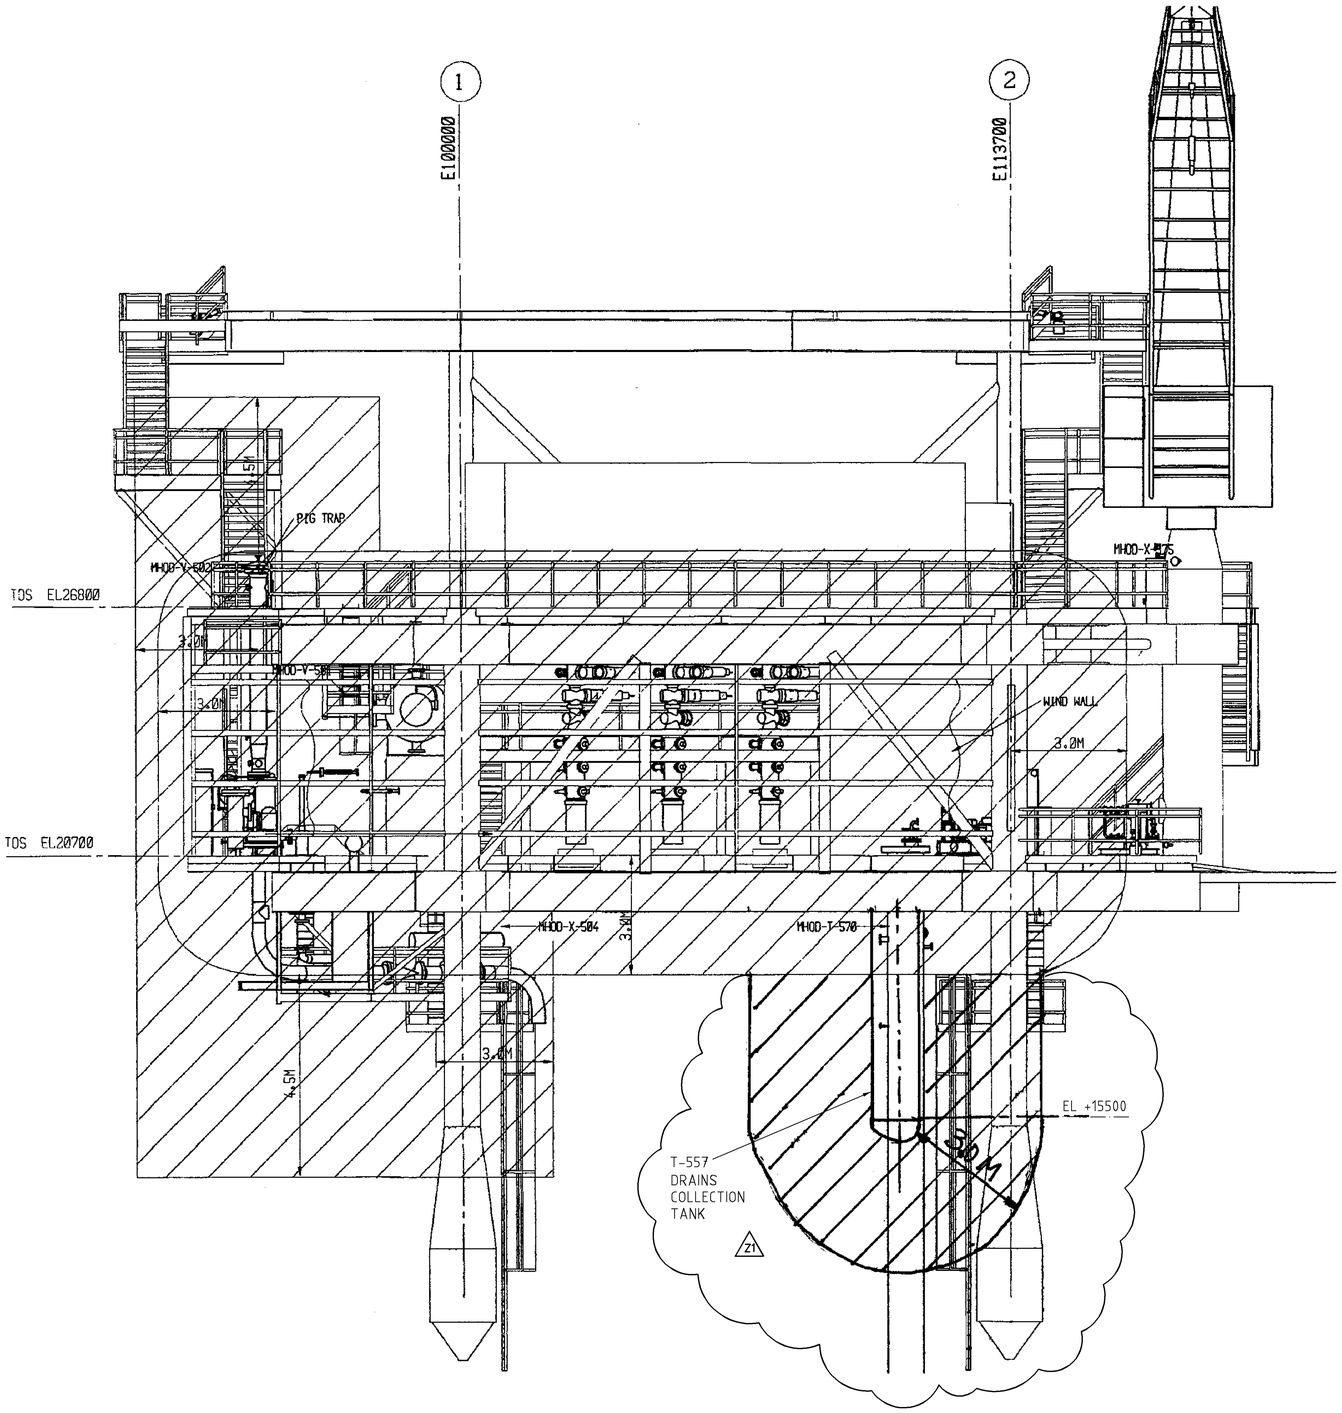

ELEVATION LOOKING NORTH

EQUIPMENT No.	DESCRIPTION
MHOD-V-501	TEST SEPARATOR
MHOD-V-502	PIG LAUNCHER
MHOD-X-504	METER PROVER
MHOD-T-570	OILY WATER SUMP CAISSON
MHOD-X-575	CHEMICAL INJECTION PACKAGE
MHOD-X-551	DIESEL TRANSFER PACKAGE
MHOD-X-590	LIFEBOAT

NOTES

1. AREA CLASSIFICATION IS BASED ON THE FOLLOWING :
   NPD REGS. FOR PROD. AUX. SYSTEMS
   DNV RP C102
   BS. 5345 PT2
   API RP 500B
   N.P.D GUIDELINES FOR AREA CLASSIFICATION (1.11.83)

2. THE PLATFORM & PLANT ARE CLASSIFIED FOR :
   GAS GROUP IIA TEMP CLASS T 3

AREA CLASSIFICATION LEGEND

- (P) VENTILATED (50pa MINIMUM DIFFERENTIAL)
- ZONE 1
- ZONE 2 NATURALLY VENTILATED

REV.	REASON FOR ISSUE	DATE	DRN BY	CHK BY	L.E. DISC.	P.E. APP.	CLIENT APP.
Z1	AS BUILT, AFA H3645	300811	ILF	AH	TH		LAA
Z	AS BUILT	121198	HN				
1	APPROVED FOR CONSTRUCTION	263589	ALF	R.G		R.G	J.P.F

REF. DWG. NO.	DESCRIPTION REF. DRAWINGS	REF. DWG. NO.	DESCRIPTION REF. DRAWINGS
HOD-LT-5940	AREA CLASSIFICATION LAYOUT CELLAR DECK		
HOD-LT-5941	AREA CLASSIFICATION LAYOUT MAIN DECK		
HOD-LT-5943	AREA CLASSIFICATION LAYOUT ELEVATION LOOKING WEST		

VERITEC
Veritec Offshore Technology and Services A/S

DRAWN BY	DATE	CHK'D. BY	DATE
P.BAILEY	16-01-89	R.OSGOOD	24-2-89

APPROVED FOR DESIGN	APPROVED FOR BID	APPROVED FOR CONST.
AP/VT-0418- J.P.F. 16.03.89		J.P.F 02.06 89

Amoco Norway Oil Company
2/11 HOD DEVELOPMENT

DRAWING TITLE:
AREA CLASSIFICATION LAYOUT
ELEVATION LOOKING NORTH

SCALE	DRAWING NO.	TYPE	CHAIN	REV	SHEET
1/75	HOD-LT-5942	BHA	C2	Z1	