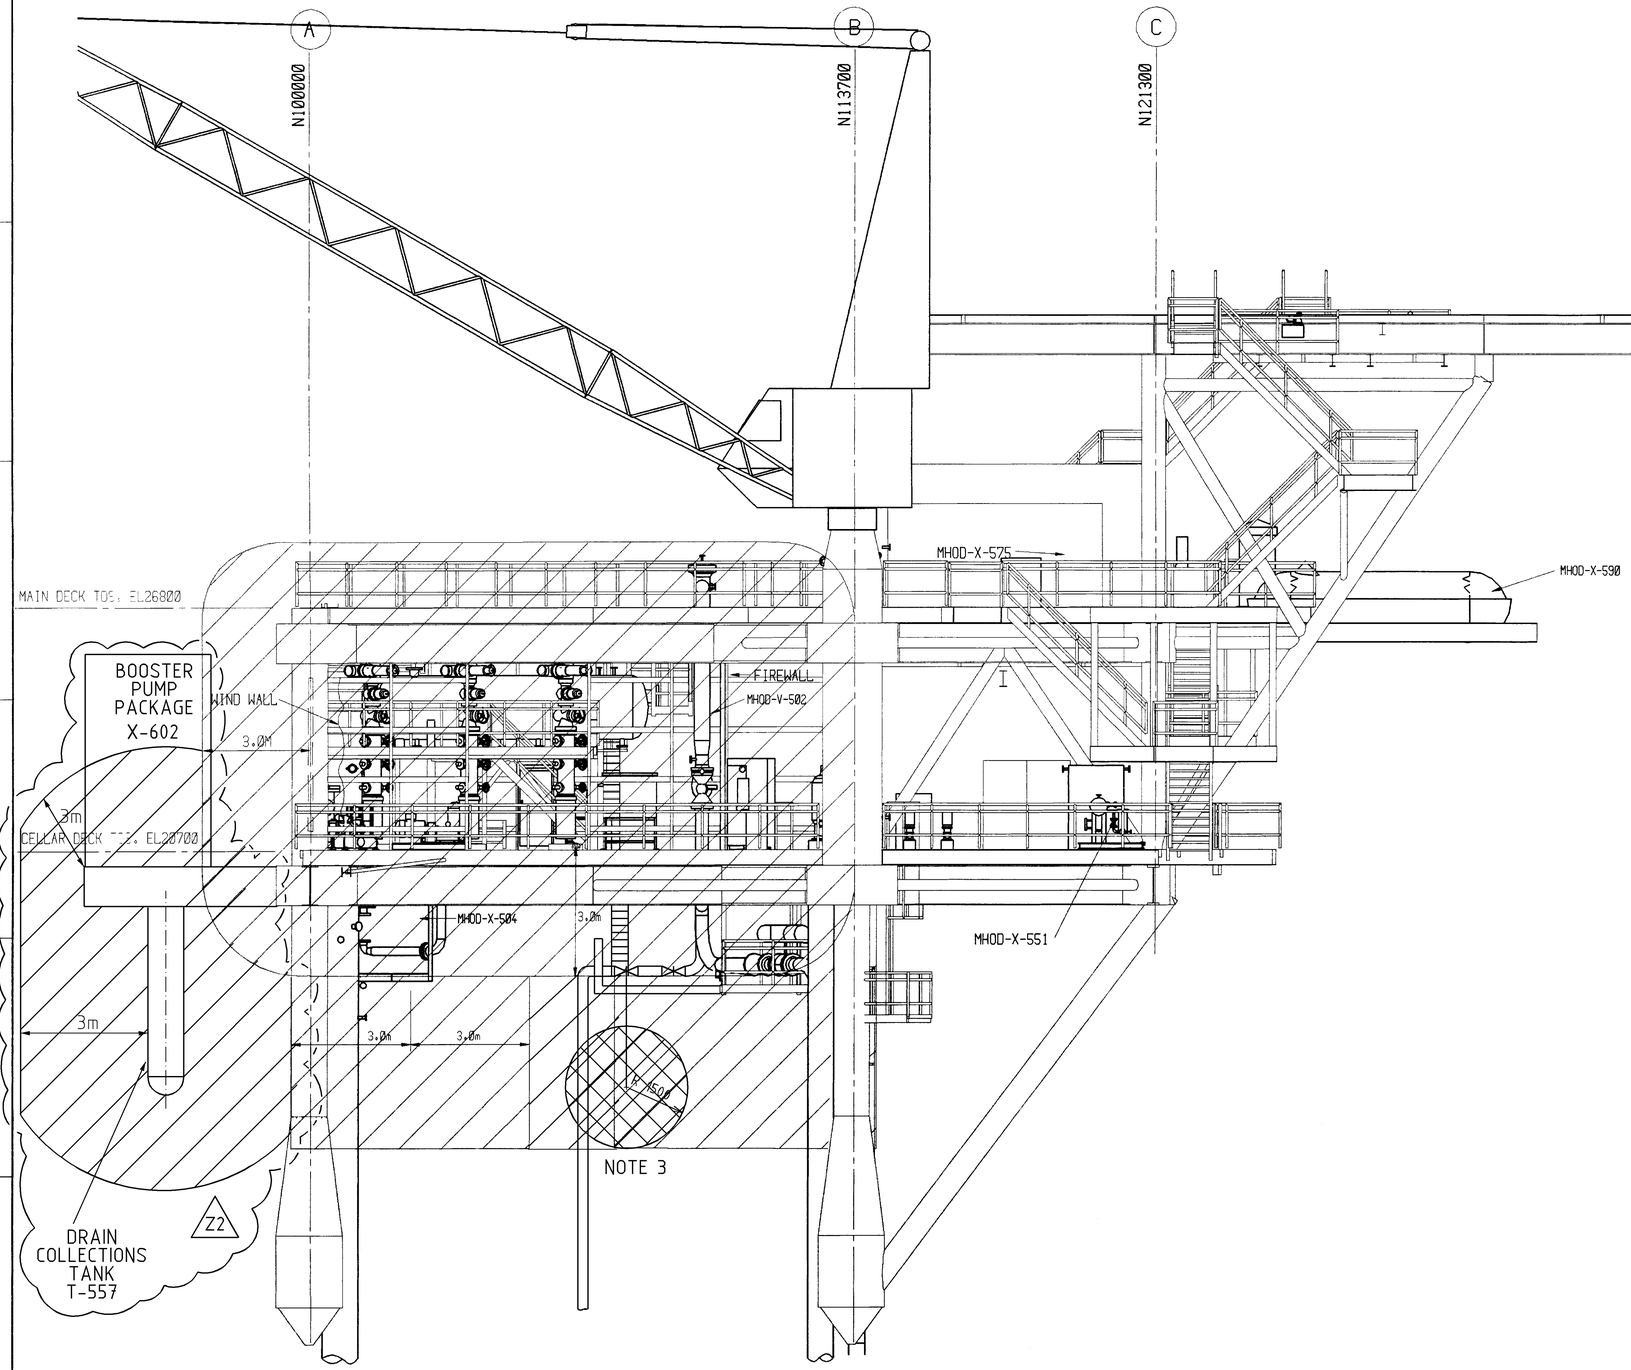

ELEVATION LOOKING WEST

EQUIPMENT No.	DESCRIPTION
MHOD-V-501	TEST SEPARATOR
MHOD-V-502	PIG LAUNCHER
MHOD-X-504	METER PROVER
MHOD-T-570	OILY WATER SUMP CAISSON
MHOD-X-575	CHEMICAL INJECTION PACKAGE
MHOD-X-551	DIESEL TRANSFER PACKAGE
MHOD-X-590	LIFEBOAT

NOTES:

1. AREA CLASSIFICATION IS BASED ON THE FOLLOWING:
   NPD REGS. FOR PROD. AUX. SYSTEMS.
   DNV RP C102
   I.E.C. 79-10
   B.S. 5345 PT2
   API RP 500B
   N.P.D GUIDELINE FOR AREA CLASSIFICATION (1.11.83)
2. THE PLATFORM & PLANT ARE CLASSIFIED FOR:
   GAS GROUP IIA TEMP CLASS T.3.
3. GAS VENT FROM RISER TOPSIDE END-FITTINGS

AREA CLASSIFICATION LEGEND

P — VENTILATED (50pa MINIMUM DIFFERENTIAL)

ZONE 1

ZONE 2
NATURALLY VENTILATED

REV	REASON FOR ISSUE	DATE	DRN BY	CHK BY	L.E. DISC.	P.E. APP.	CLIENT APP.
Z2	AS BUILT, AFA H3645	300811	ILF	AH	TH		LAA
Z1	AS BUILT BPA99228	221190	RG	EH	SRØ	HJS	
Z	AS BUILT	121190	HN				
1	APPROVED FOR CONSTRUCTION	310589	ALF	R.O	N.L	R.G	J.P.F

REV.	REASON FOR ISSUE	DATE	DRN BY	CHK BY	L.E. DISC.	P.E. APP.	CLIENT APP.

REF. DWG. NO.	DESCRIPTION REF. DRAWINGS
HOD-LT-5940	AREA CLASSIFICATION LAYOUT - CELLAR DECK
HOD-LT-5941	AREA CLASSIFICATION LAYOUT - MAIN DECK
HOD-LT-5942	AREA CLASSIFICATION ELEVATION - LOOKING NORTH
HOD-LT-5966	AREA CLASSIFICATION LAYOUT - SUB CELLAR DECK

REF. DWG. NO.	DESCRIPTION REF. DRAWINGS

VERITEC
Veritec Offshore Technology and Services A/S

DRAWN BY	DATE	CHK'D. BY	DATE
A.ALFSVAAG	21.02.89	R.OSGOOD	24.02.89

APPROVED FOR DESIGN	APPROVED FOR BID	APPROVED FOR CONST.
AP/VT-0418 J.P.F. 16.03.89		J.P.FRANZ 02.06.89

Amoco Norway Oil Company
2/11 HOD DEVELOPMENT

DRAWING TITLE:
AREA CLASSIFICATION LAYOUT
ELEVATION LOOKING WEST

SCALE	DRAWING NO.	TYPE	CHAIN	REV	SHEET
1/75	HOD-LT-5943	BHA	C2	Z2	001

File HOD-LT-5943.DGN