DRAWING No. A1:1 - 2100-17

EQUIPMENT LIST

ITEM No	VENDORS ITEM NO	DESCRIPTION	ELEVATION
4102A&B		MUD PUMP N° 1 & 2	W/S SKID EL 32167
4103A-C		PRECHARGING PUMP N° 1,2&3	W/S SKID EL 32167
4104A&B		MUD MIXING PUMP N° 1&2	W/S SKID EL 32167
4105A&B		MUD TRANSFER PUMP N° 1&2	W/S SKID EL 32167
4106A&B		DESILTER PUMP. N° 1&2	W/S SKID EL 32167
4132		CENTRIFUGE FEED PUMP	
4119 A&B		CENTRIFUGE SUPPLY PUMP	
4121A&B		SOLVENT CIRC PUMPS N°1&2	W/S BASE EL 32167
4122A,B,C		WATER DISCHARGE PUMPS	W/S SKID EL 32167
4313		WASH DRUM	
4307		CUTTINGS CLEANER	
4312		SEPARATOR	W/S SKID EL 32132
4052A&B		CUTTINGS CLEANER DISCHARGE CHUTE	
4053		CUTTINGS CLEANER FEED CHUTE	
5201A-P		MUD TANKS	
5202		SAND TRAP & SHALE CHUTE	
5207A&B		CRANE PEDESTAL N°1&2	
5222		SOLVENT MAKE UP TANK	W/S TANK EL 34200
5227A&B		SOLVENT RESERVOIR TANK	
5233		COARSE TANK	
7005		MUD PUMP LOCKOUT STN	W/S BASE EL 32167
8005		BULK STORAGE AIR CONVEYING SYSTEM CONTROL CABIN	
4959		DRY POWER LOADING SKID	
8503		BULK STORAGE CONTROL CABIN SYSTEM	
4128		SUMP PUMP	
6601A,B		H.P. PULSATION DAMPERERS	

REFERENCE DRAWINGS

MUD MODULE GA - MEZZANINE FLOOR - EL+36592	A1-2100-18
MUD MODULE GA - ROOF - EL+42120	A1-2100-19
MUD MODULE SECTIONS - AA-BB & CC	A1-2100-20

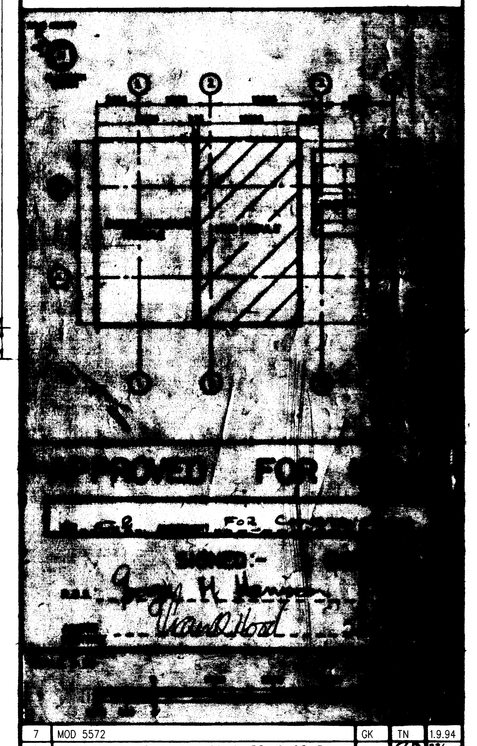

No	AMENDMENTS	BY	APPD	DATE
7	MOD 5572	GK	TN	19.94
6	REVISED AS INDICATED, MOD 5930, AS-BUILT	J.R.	[illegible]	[illegible]
5	REVISED AS INDICATED ; AS BUILT	W.J.L	[illegible]	[illegible]
4	OPPMERKING AV LØFTEUTSTYR	G.K.	[illegible]	[illegible]
C3	Mod. 2159	[illegible]	[illegible]	[illegible]
C2	REVISED AS NOTED	[illegible]	[illegible]	[illegible]
C1	RE-ISSUED FOR CONSTRUCTION	[illegible]	[illegible]	[illegible]
C	ISSUED FOR CONSTRUCTION	[illegible]	[illegible]	[illegible]
0	ISSUED FOR COMMENT	AM		

RIG DESIGN SERVICES LTD
CONSULTING ENGINEERS
4 GREAT PORTLAND STREET, LONDON W1N 5AA ENGLAND
TELEPHONE 0-637 8444 TELEX 27598 RIGS G

CLIENT	AMOCO
PROJECT	VALHALL DEVELOPMENT
TITLE	MUD MODULE GENERAL LAYOUT OF LOWER DECK EL 32132
DESIGNED	RDS
DRAWN	T&S 10-3-95
CHECKED	
SCALE	1:50
APPROVED	
DRAWING No	A1:1 - 2100-17
SHEET	SHEET C4 5 16 7

KOPI SENDT TIL:
Tegnekont.
Planlegging
Kalkyle
Rubberlid
Lønnsstyre
Hvse
Silkeruik
Olsen
Hugco
Karlsen

EXPLORATION REPROGRAPHIC A 52789 0884