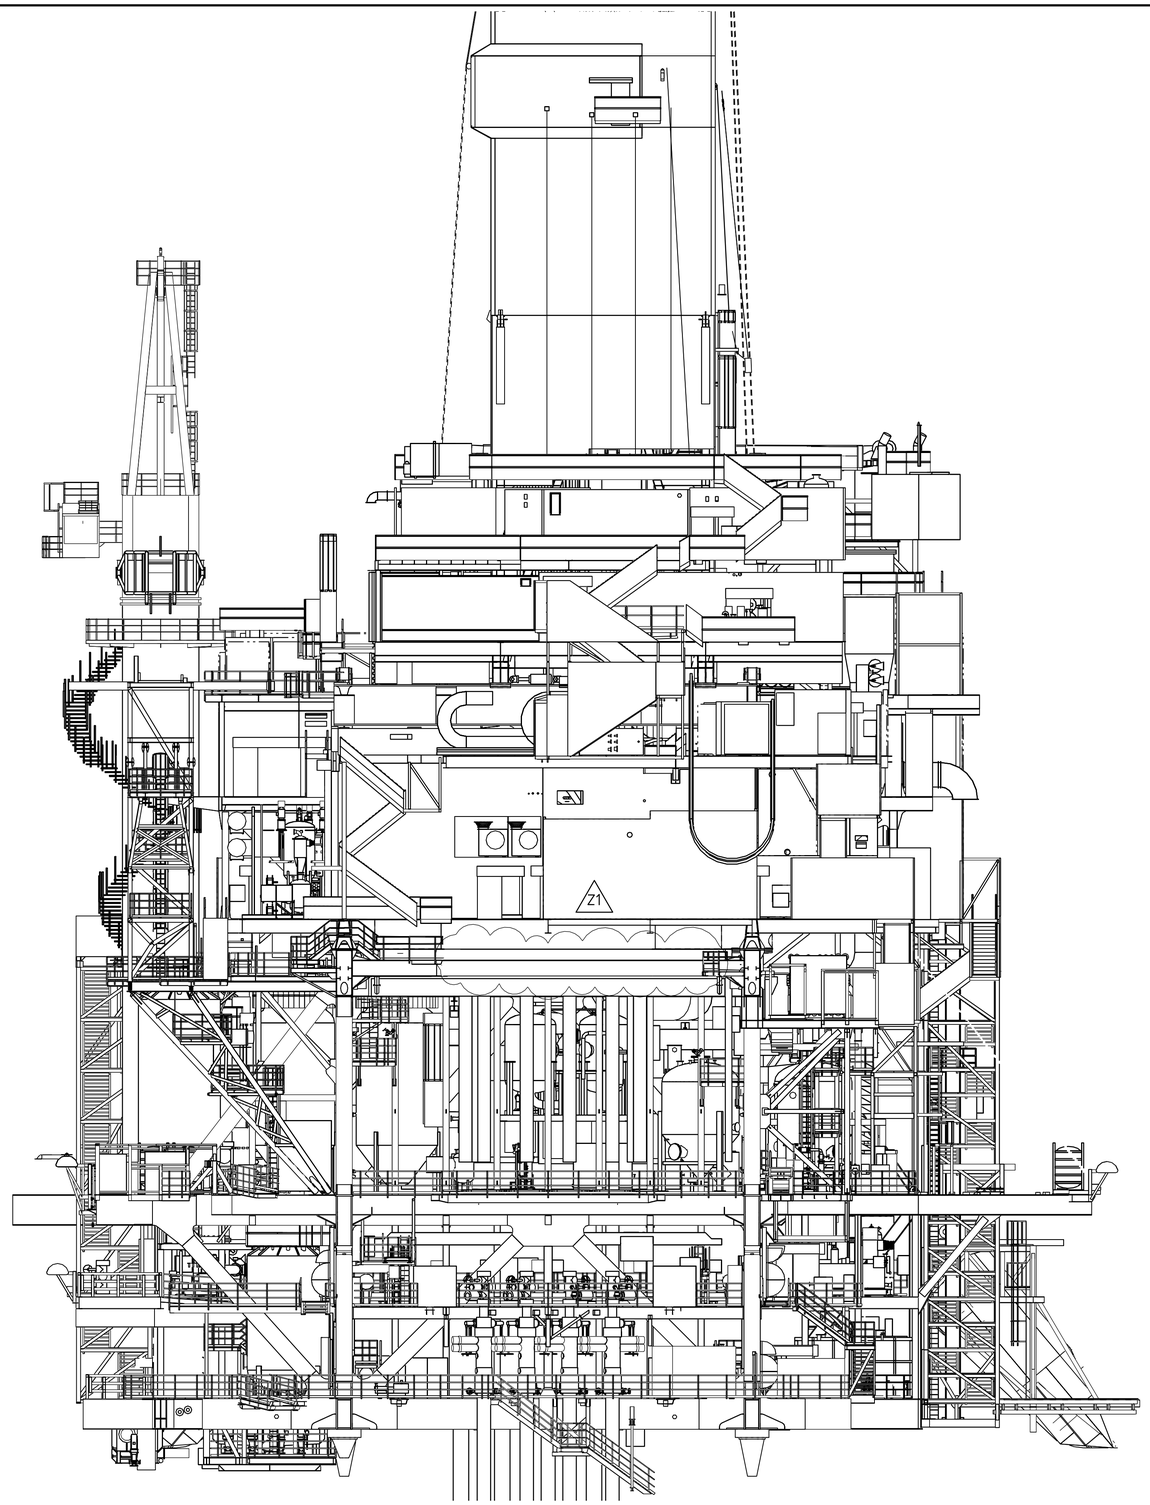

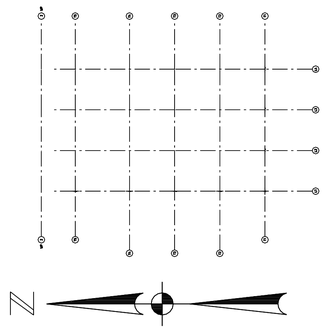

REV. No.	DESCRIPTION OF REVISION	ISSUE DATE	MADE BY	CHK'D BY	DISC. APPR.	PROJ. APPR.	CLIENT APPR.
01	ISSUED FOR QL1 COMMENTS	04.12.00	OST	WH	WH		
02	ISSUED FOR QL1	22.12.00	OST	WH	WH		
03	ISSUED AS UPDATED	020201	OHS	WH	WH		
4	ISSUED FOR QL2	300301	OST	WH	WH		
05	ISSUED FOR QL3	070501	OST	WH	WH		

REV. No.	DESCRIPTION OF REVISION	ISSUE DATE	MADE BY	CHK'D BY	DISC. APPR.	PROJ. APPR.	CLIENT APPR.
06	ISSUED FOR QL4	210901	OST	WH	WH		
Z	AS-BUILT	100902	OST				
Z1	AS BUILT AFA-004046	12.03.13	JSA	MVR	JPP		

Valhall Water Injection Project

Aker Maritime

REF. DWG. No.	REF. DRAWING TITLE

bp

PLOT PLAN
ELEVATION
LOOKING SOUTH-WEST

REGISTRATION CODES		
AREA	SYSTEM	TYPE
A00	00	XE

DRAWING NO.					SCALE
FACILITY CODE	ORIG.	DISP.	SEQ. No.	SHEET	1:150
IP	AO	L	0009	01	REV. Z1