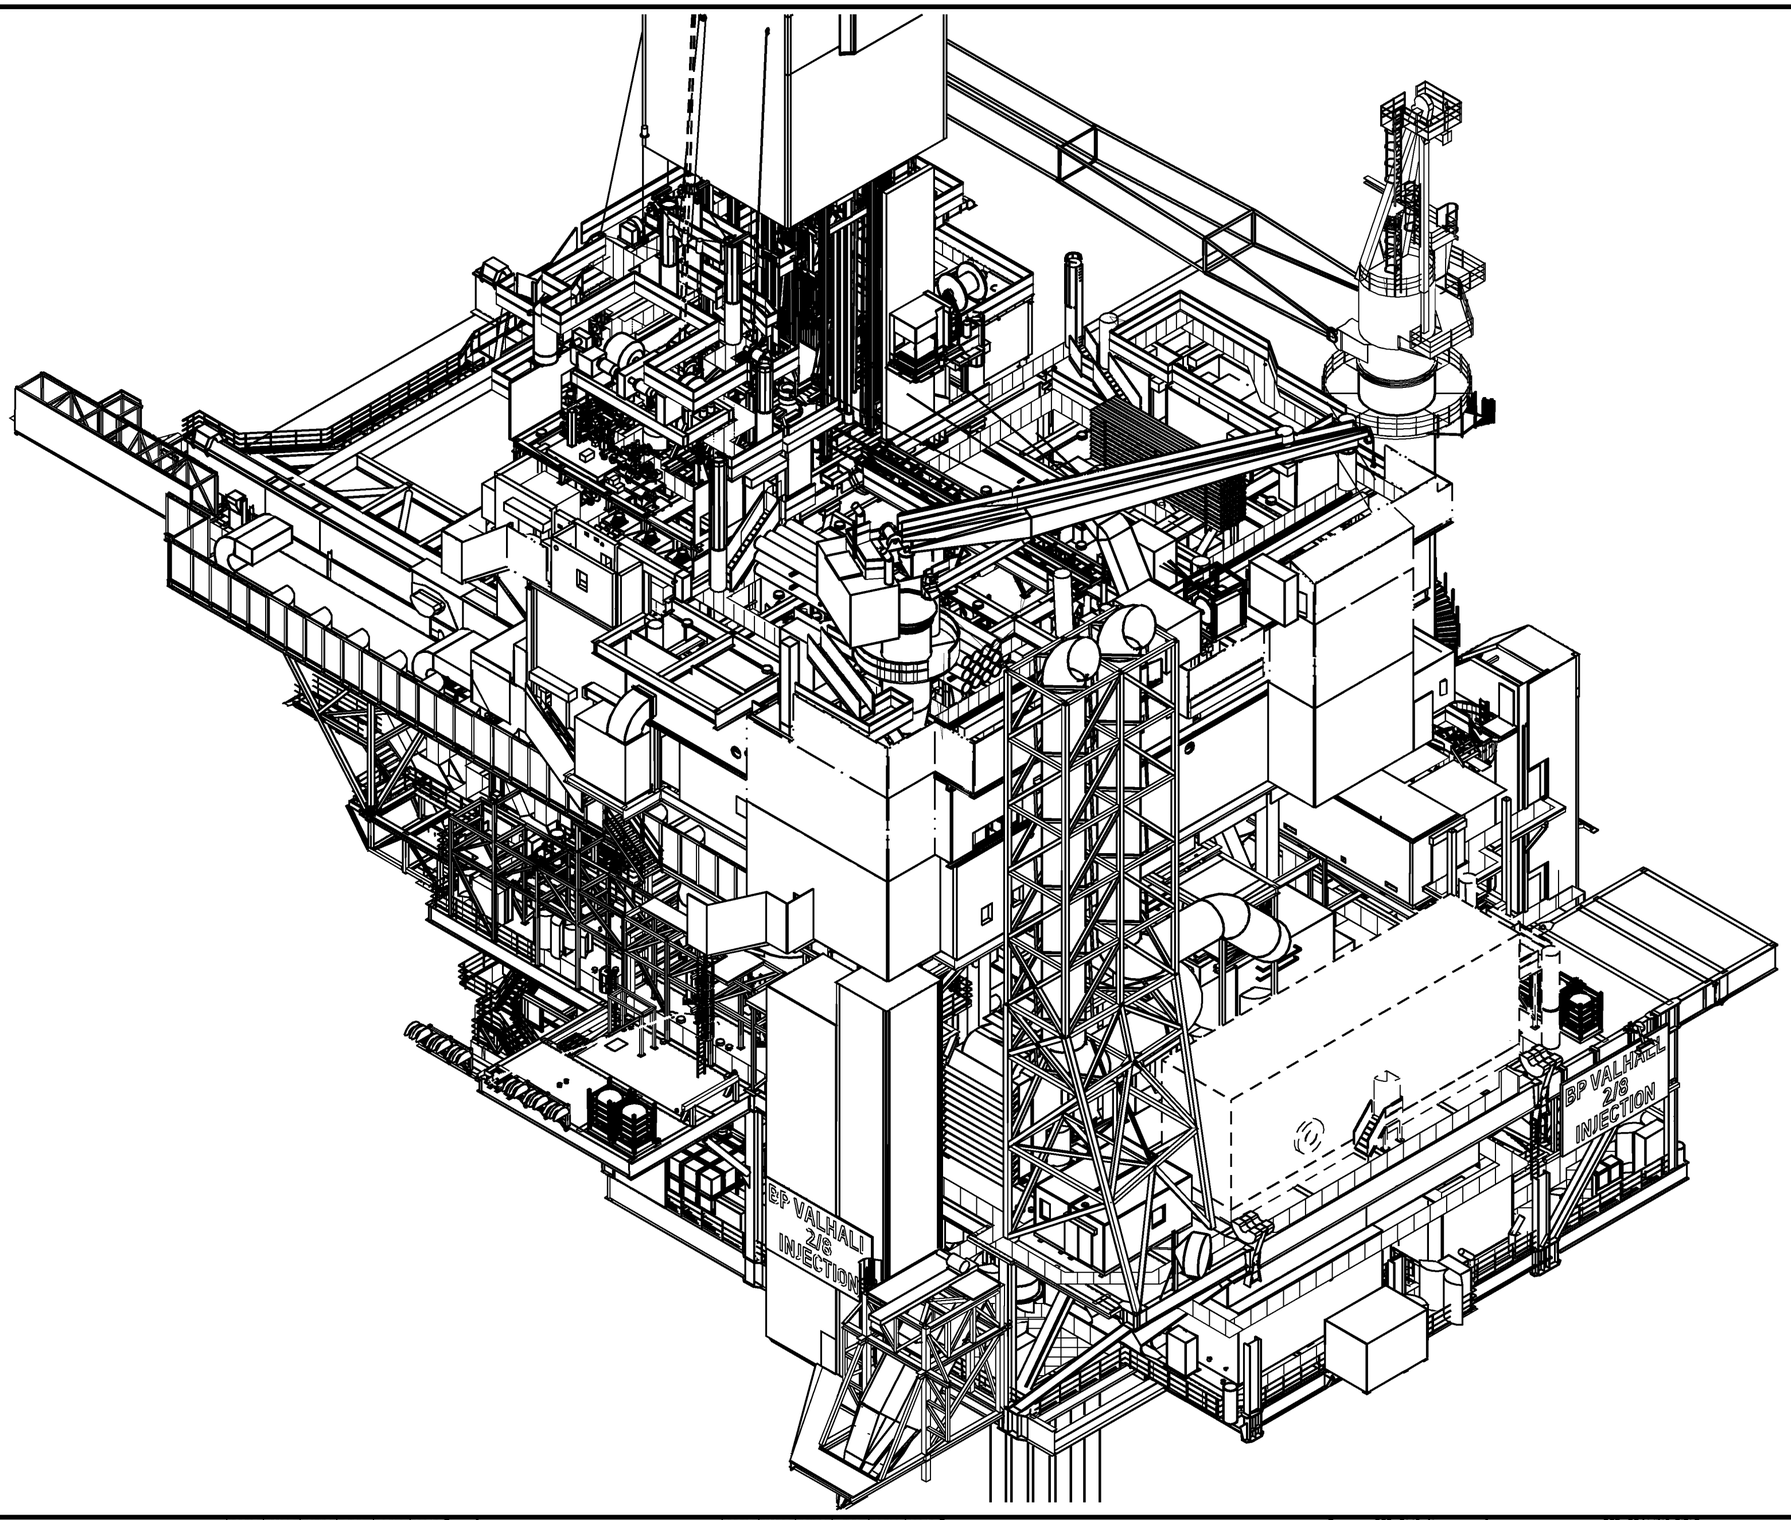

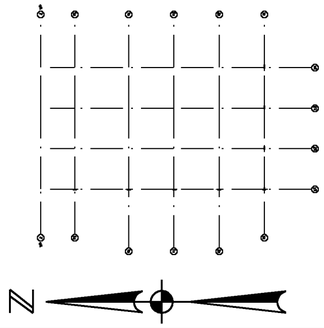

REV No	DESCRIPTION OF REVISION	ISSUE DATE	MADE BY	CHK'D BY	DISC APPR	PROJ APPR	CLIENT APPR
01	ISSUED FOR QL1 COMMENTS	04 12 00	OST	WH	WH		
02	ISSUED FOR QL1	22 12 00	OST	WH	WH		
03	ISSUED AS UPDATED	020201	OHS	WH	WH		
04	ISSUED FOR QL2	300301	OST	WH	WH		
05	ISSUED FOR QL3	070501	OST	WH	WH		

REV No	DESCRIPTION OF REVISION	ISSUE DATE	MADE BY	CHK'D BY	DISC APPR	PROJ APPR	CLIENT APPR
06	ISSUED FOR QL4	210901	OST	WH	WH		
Z	AS-BUILT	100902	OST				

Valhall Water Injection Project

Aker Maritime

REF DWG No	REF DRAWING TITLE

bp

PLOT PLAN
ISOMETRIC VIEW
LOOKING NORTH-EAST

REGISTRATION CODES		
AREA	SYSTEM	TYPE
A00	00	XE

DRAWING NO					SCALE
FACILITY CODE	ORIG	DISP	SEQ No	SHEET	1:150
IP	AO	L	0010	01	REV Z

VHL: TUE SEP 10 13:06:05 2002