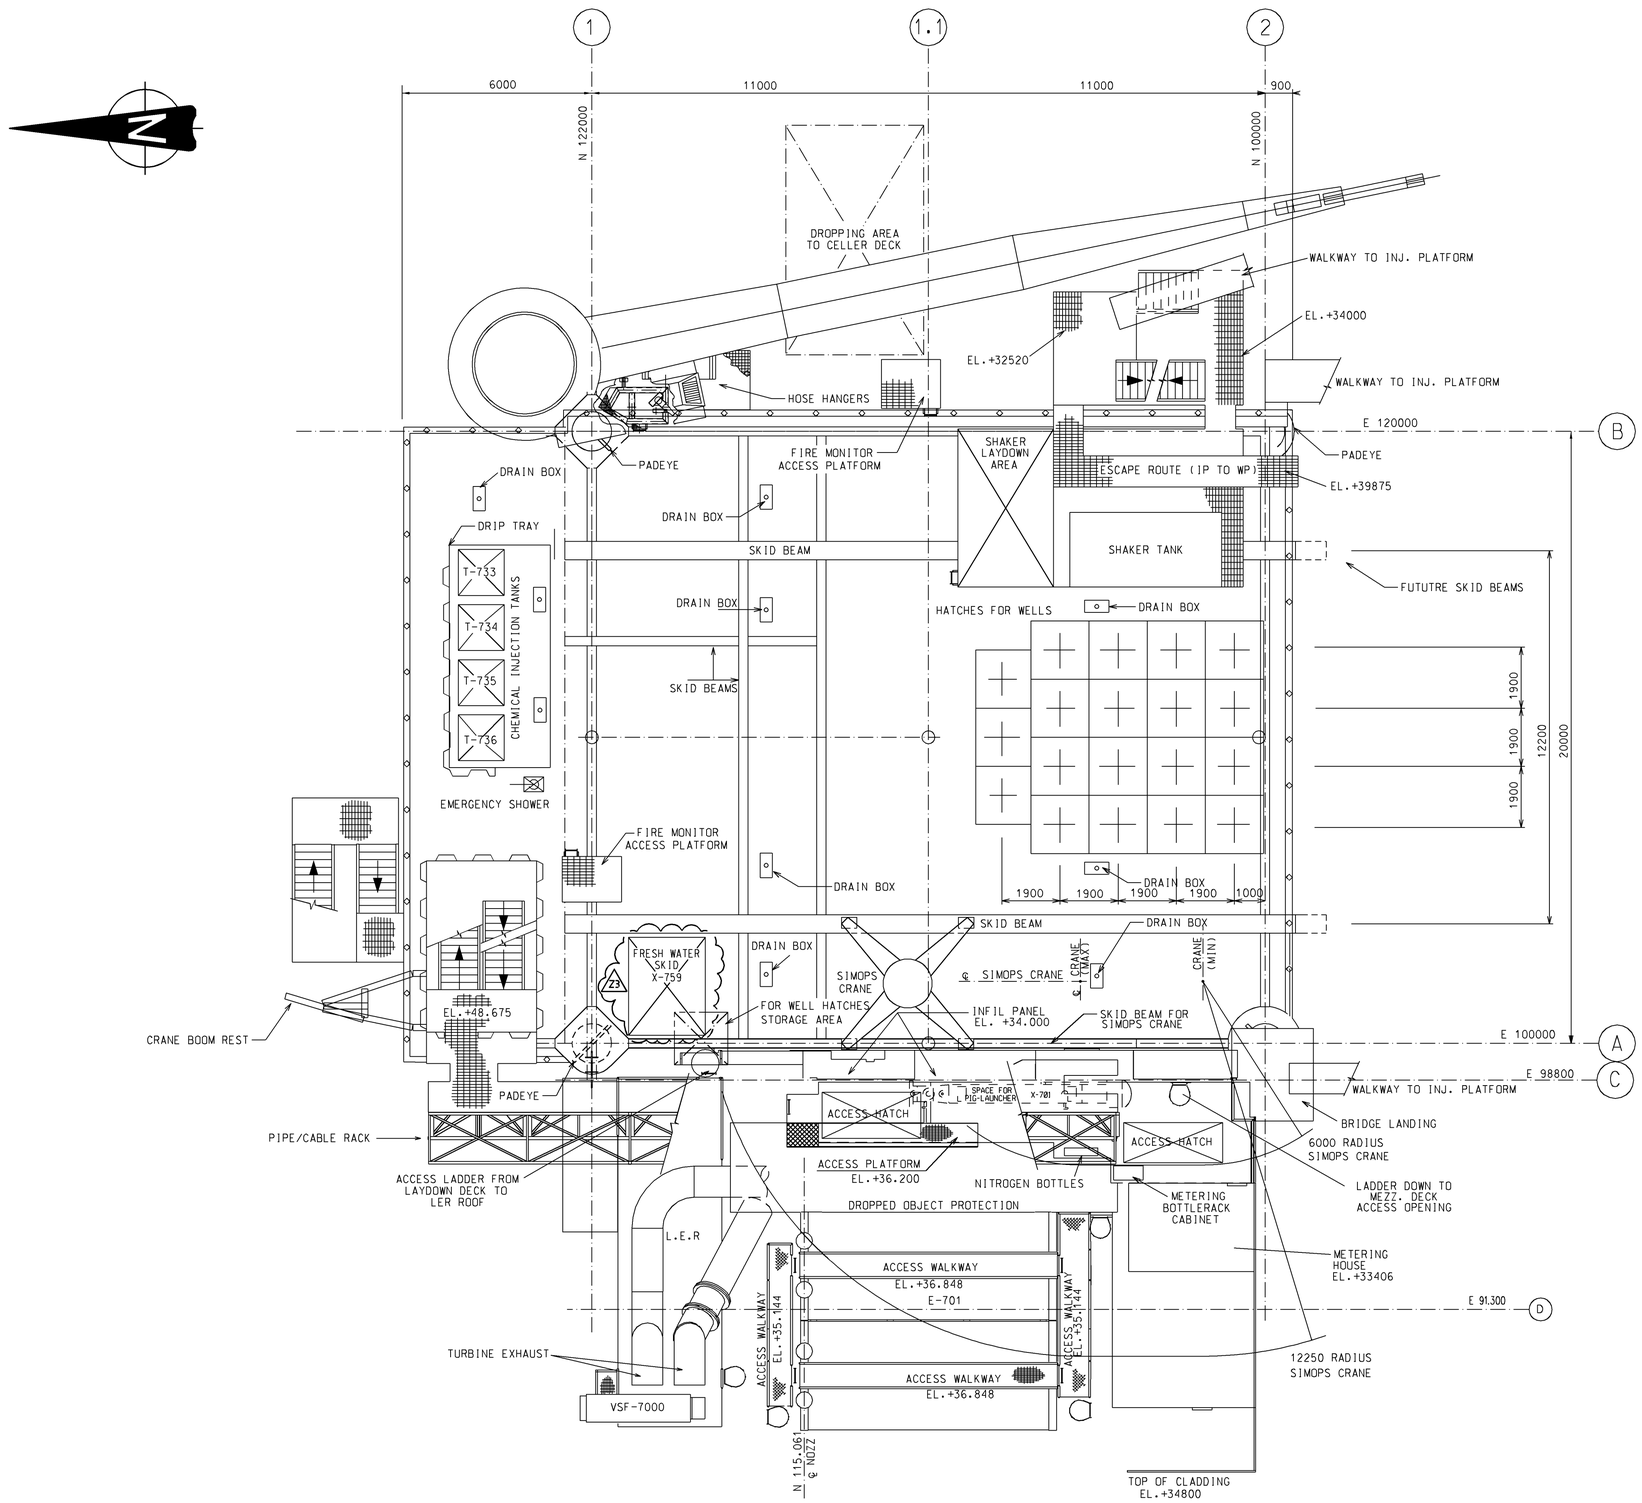

0 1 2 3 4 5 6 7 8 9 10M

GRAPHIC SCALE
1 : 100

NOTES

REFERENCE DRAWINGS		REV	DATE	BY	DESCRIPTION	CHKD	APPD	APPD
DRAWING No.	DESCRIPTION	Z	18.04.96		AS BUILT			
.	.	Z1	04.99	MAMY	AS BUILT- EQM MODULE INCLUDED	MAU	TA	
		Z2	13.04.04	GB	AS BUILT C01031	PT	TH	
		Z3	06.04.05	SMR	AS BUILT. AFA V-3344	HS	KG	IM

	SIGNED	DATE
DRAWN BY	.	.
CHECKED BY	.	.
APPROVED BY	.	.
APPROVED CLIENT	.	.

ABB OFFSHORE SYSTEMS

VALHALL WP PROJECT

CLIENT AMOCO NORWAY OIL COMPANY

TITLE
PLOT PLAN
MAIN DECK
T.O.DECK EL.+34000

SCALE	Format	DRAWING No.	SHT. No.	REV
1 : 100	A1	00-07-00-PP-001	1	Z3

1978-009

ORIGINAL SIZE A1