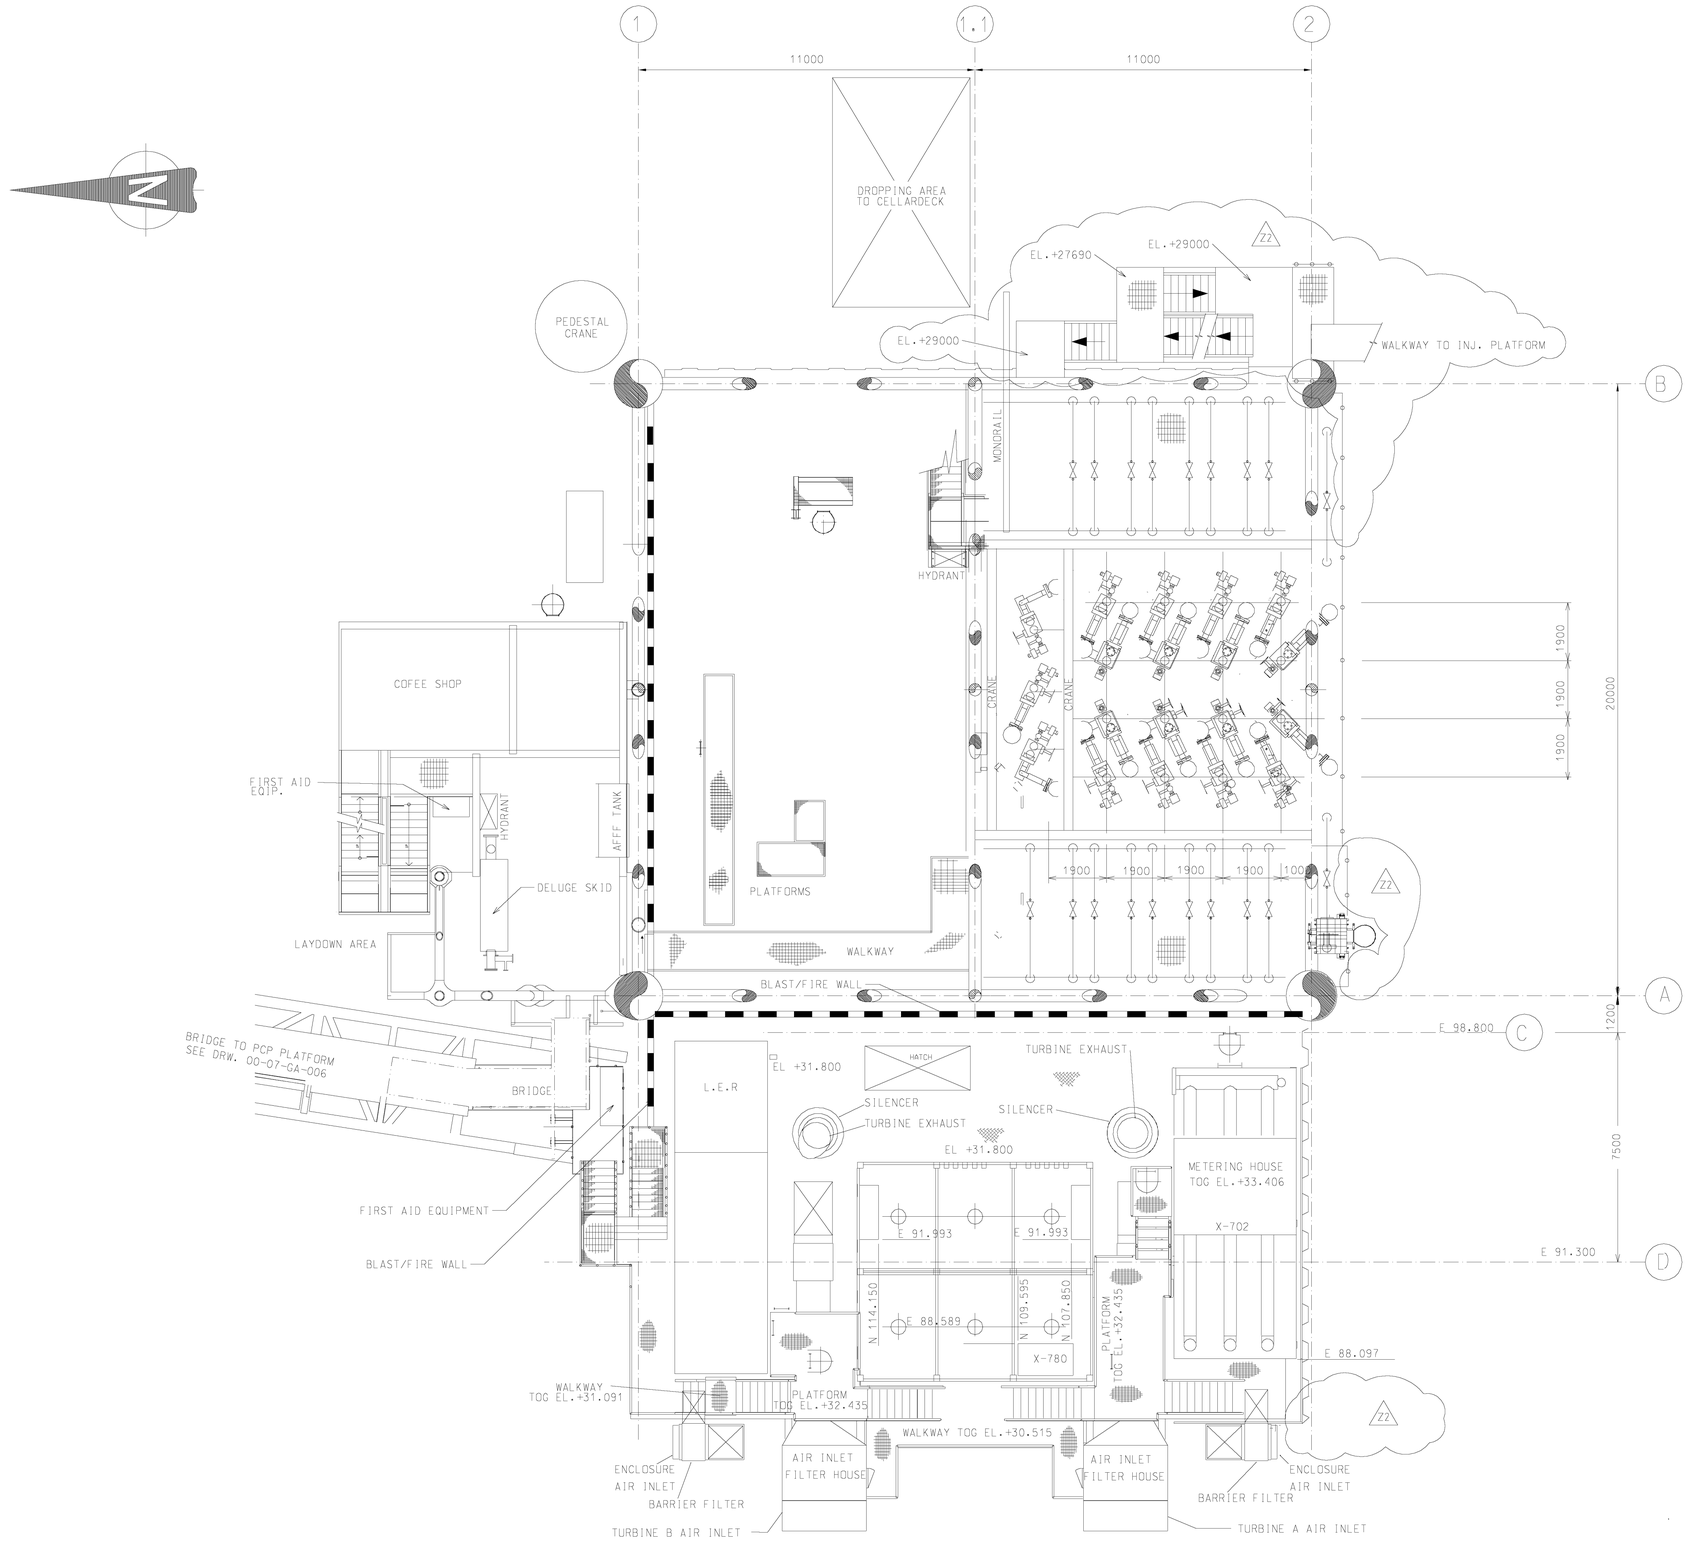

0 1 2 3 4 5 6 7 8 9 10M

GRAPHIC SCALE
1 : 100

NOTES

REV	DATE	BY	DESCRIPTION	CHKD	APPD	APPD		SIGNED	DATE
							DRAWN BY	.	. .
							CHECKED BY	.	. .
Z2	13.04.04	GB	AS BUILT C01031	PT	TH		APPROVED BY	.	. .
Z1	04.99	MAMY	AS BUILT- EQM MODULE INCLUDED	MAU	TA				
Z	18.04.96		AS BUILT				APPROVED CLIENT	.	. .

DRAWING No. . .

DESCRIPTION

REFERENCE DRAWINGS

ABB OFFSHORE SYSTEMS

VALHALL WP PROJECT

CLIENT AMOCO NORWAY OIL COMPANY

TITLE
PLOT PLAN
MEZZANINE DECK
T.O.DECK EL.+29000

SCALE	Format	DRAWING No.	SHT. No.	REV
1 : 100	A1	00-07-00-PP-002	1	Z2

ORIGINAL SIZE A1

1978-009